


Section 21 Township 14 Range 14 W

Well No. # 1 Boxberger

Company Duke & Wood

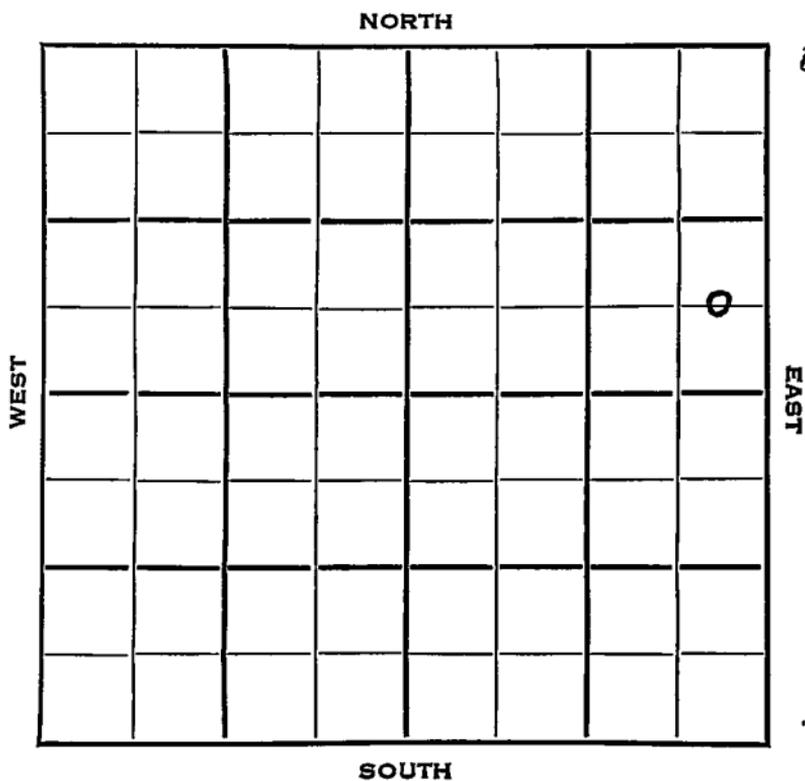

Russell KANSAS

SEC.	TWP.	R.
21	14	14 W

WELL NO. # 1 Boxberger FARM

COMPANY Duke & Wood


CONTRACTOR Duke & Wood

1900 Ft. from N. Line

Ft. from S. Line

330 Ft. from E. Line

Ft. from W. Line

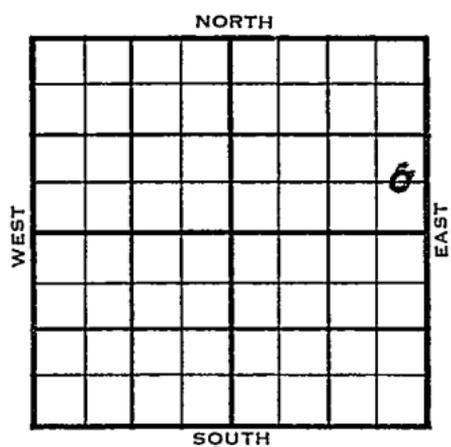

C E L S E N E

	ELEVATION	REPORT
1953	Elev. 1861'	

9/30 Spud 9-25-53
8" @ 252
Drlg. 1925'

10/7 Anhy 854' 2nd Tarkio 2416'
RTD 2440' 5" @ 2440'

10/14 CO, 2437
43/2417-21 1/2
S/10 goph
Sd-o-frac
S/5 boph

10/21 Spud 9-25-53
Oil Wel
TD 2440
8" @ 252
Anhy 854, Tarkio 2416
TD 2440
5" @ 2440
CO to 2437
43/2417-21,
S/10 goph
sd-oil-frac
S/5 boph
S/ 2 boph
Comp. 25 bopd

COMPLETED

