


Section 22 Township 14 Range 16WWell No. #1 TholenCompany Sinclair Oil

NORTH

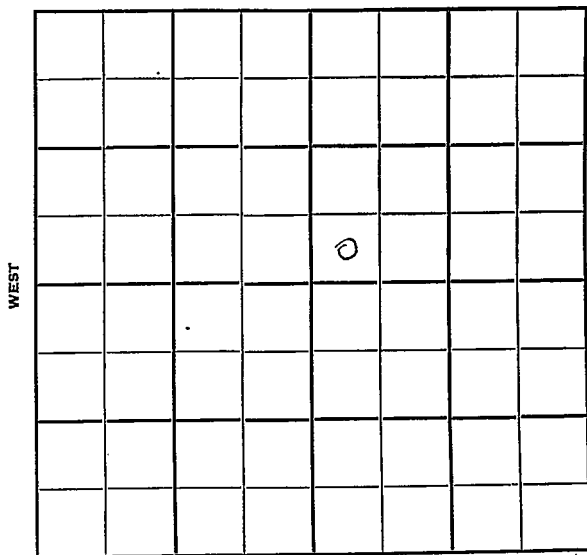

SOUTH

Ellis

KANSAS

Sec. 22 Twp. 14 R. 16W

Well No. #1 Tholen Farm

Sinclair Oil Company

Anschutz Drlg. Contractor


 Ft. from N. Line

330' Ft. from S. Line

 Ft. from E. Line

330' Ft. from W. Line

SW SW NE

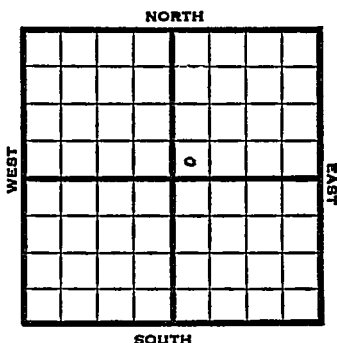

1951

Elev. 1890' REPORT

4/11

5/16

Location

Spud 5-1-51

D & A TD 3445' 10" @ 260'

Top. 2826' Heeb 3088' Tor 3108'


Lans. 3135'

DST 3138-80 open $\frac{1}{2}$ hr. rec 480' mud &

SW Cong 3386' Arb. 3419'

TD 3445' D & A

ABANDONED

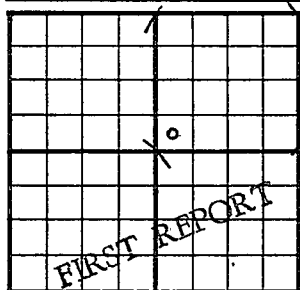County Ellis State KansasSec. 22 (Blk. Twp.) 14 (Sur. Rge.) 16W Map No.Operator Sinclair OilWell No. 1 Farm TholenElev. Location SW SW NE330 Ft. From S Line NE330 Ft. From W Line Quarter1st. Report APR 11 1951

Completion


Remarks

Spudding Date

Drlg. Data

Location

J. E. TYRA

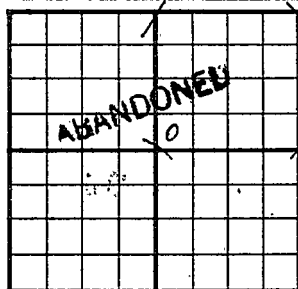County Ellis State KansasSec. 22 (Blk.
Twp.) 14 (Sur.
Rge.) 16W Map No.Operator Sinclair OilWell No. 1 Farm TholenElev. 1890 Location SW SW NE330 Ft. From S Line NE330 Ft. From W Line Quarter

1st. Report

Completion MAY 16 1951

Remarks

Anschutz Drlg. - Contr.Spudding Date 5-1-51Drlg. Data D & A TD 344510" @ 260 Top. 2826 Heeb. 3088Tor. 3108 Lans. 3135 DST 3138-80open $\frac{1}{2}$ hr. Rec. 480' mud & swConc. 3386 Arb. 3419 TD 3445D & A

J. E. TYRA