


Section 22 Township 14 Range 16W

Well No. #4 M. P. Dreiling

Company Atlantic Ref.

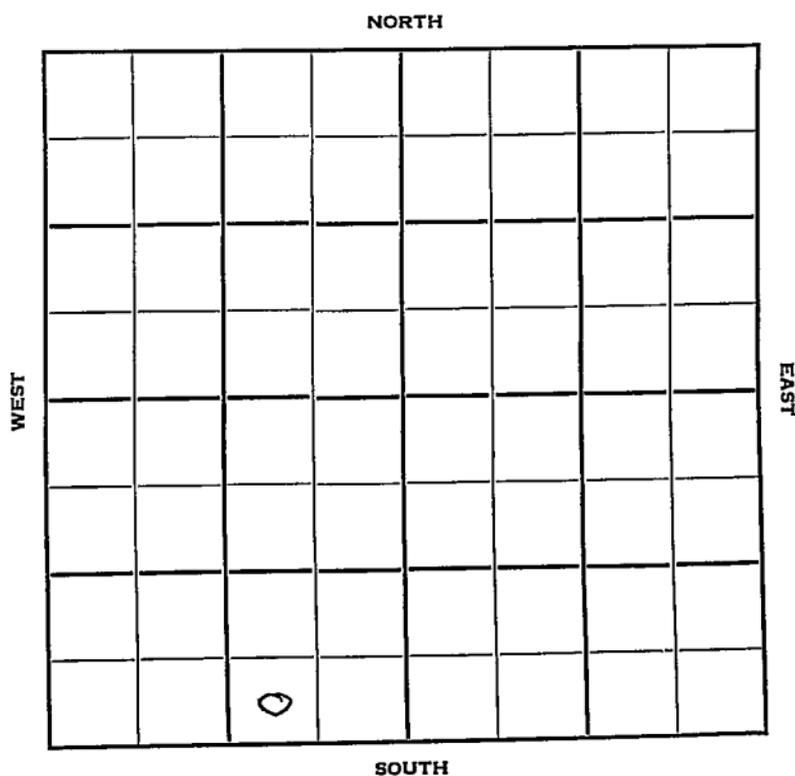

/

Ellis

KANSAS

Sec. 22 Twp. 14 R. 16W

Well No. #4 M. P. Dreiling Farm

Atlantic Refg. Company

Contractor

Ft. from N. Line


330 Ft. from S. Line

990 Ft. from E. Line

Ft. from W. Line

SW $\frac{1}{4}$

SW SE SW

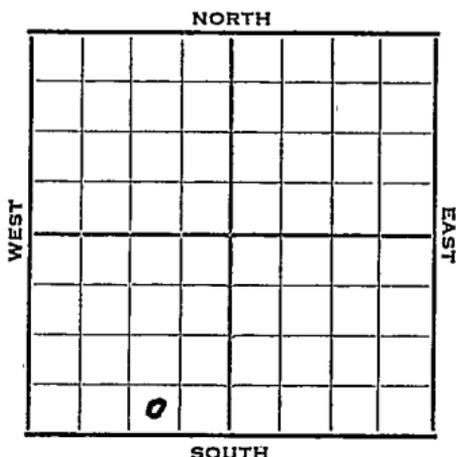

1952 Elev. 1854' REPORT

10/22 Spud 10-19-52
9" @ 254'

10/29 Heeb 3050' Tor. 3071' Lans. 3099'
DST 3100-3132'

11/5 DST 3100-3132, 1 hr. 130' m 655#
DST 3155-91, 1 hr. 85' MCSW 805#
DST 3270-3305, 1 hr. 15' m 955#
Arb. 3352
DST 3354-60, 1 hr. 90' oil 120'
muddy oil 570# TD 3360'
7" @ 3358'

11/12 CO 3360' log 250A S/ 1 1/2 boph

11/20 NR

11/27 "

12/3 Spud 10-19-52
Oil Well
TD 3360'
9" @ 254'
Heeb 3050, Tor. 3071, Lans
3099
DST 3100-3132, opn 1 hr., rec.
130' mud, 655#
DST 3155-91, opn 1 hr., rec.
85' mcsw 805#
DST 3270-3305, opn 1 hr., rec.
15' mud, 955#
Arb. 3352

OVER

(Information Brought Forward)

1952
12/3

DS[#] 3354-60, opn 1 hr., rec.
90' oil, 120' muddy oil 570 #
TD 3360
7" @ 3358,
CO to 3360, 250A
S/1 $\frac{1}{2}$ boph
Comp. 36 bopd 5% wtr.

COMPLETED

Scout Cards	<i>A. J.</i>
Land Small Map	
Land Wall Map	53
Tracings	
France Map	
Pierce Map	
Misc.	

OCT 27 1952

Scout Cards	_____
Land Small Map	_____
Land Wall Map	_____
Tracings	_____
France Map	_____
Pierce Map	_____
Misc.	_____

AD

69

DEC 10 1952