

D. W. P. B.

KANSAS


FORM 51 25M. 3-49 PETROL

Ellis

Section 22 Township 14 Range 16W

Well No. #1 Dreiling

Company Atlantic

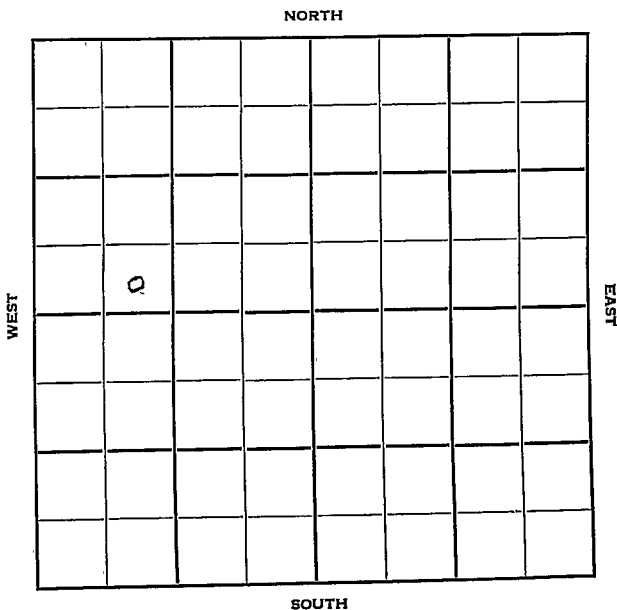

duplicate

KANSAS

Ellis ✓

Sec. 22 Twp. 14 R. 16-W

Well No. #1Dreiling Farm

Atlantic Company

Contractor


Dreiling Pool
Ft. from N. Line

330 Ft. from S. Line

Ft. from E. Line

990 Ft. from W. Line

SE SW NW

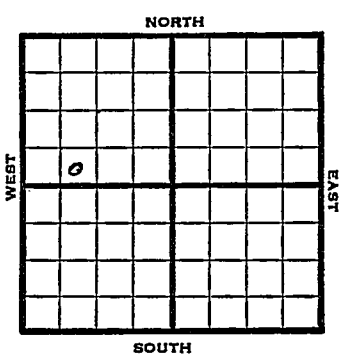

1950

Elev 1892' REPORT

1/11
3/8

RUR
TD 3403'
8" @ 230'
5" @ 3403'
Lans 3146'
Cong 3374'
Arb. 3397'
274 BOPD
4% wtr.
Comp

COMPLETED

O. W. P. B.

1950

12/20

OIL Well TD 3323
Lans. 3126 Arb. 3397
TD 3422 5" @ 3406
SP 3323 30/3127-32 P/32 bo 50% wtr
500 A Comp. 287 bopd 10% wtr.

COMPLETED

Map No. _____ Sec. 22 Twp. 14 R. 16W

Well No. 1 Dreiling

Atlantic Company

Armer Drlg. Contractor

SE SW NW

SECTION PLAT

_____ Ft. from N. Line

330 Ft. from S. Line

_____ Ft. from E. Line

990 Ft. from W. Line

FIRST REPORT			
o			

Ellis County

Location _____

Rig up _____

Drilling and Remarks:

R U R

RECORD

Cased _____ in., _____ ft.

Sand _____

Gas _____

Oil _____

Total Depth _____

PRODUCTION

1st 24 hrs. Nat. _____

1st 24 hrs. after shot _____

Gas _____ Cu. Ft.

Dry Hole _____

Abandoned _____

Date

JAN 11 1939

19

J. E. TYRA

Scout

Kansas

Map No. _____ Sec. 22 Twp. 14 R. 16W

Well No. 1 Dreiling

Atlantic Company

Contractor

SE SW NW

El. 1892
SECTION FLAT

_____ Ft. from N. Line

330 Ft. from S. Line

_____ Ft. from E. Line

990 Ft. from W. Line

COMPLETE			
o			

Ellis County

Location _____

Rig up _____

Drilling and Remarks:

8" @ 230
5" @ 340.3
Lans 3146
cong 3374
and 3397
274 BOPD

RECORD

Cased _____ in., _____ ft.

Sand _____

Gas _____

Oil _____

Total Depth 340.3

PRODUCTION

1st 24 hrs. Nat. _____

1st 24 hrs. after shot _____

Gas _____ Cu. Ft.

Dry Hole _____

Abandoned _____

4% wtr. *¢*

Date

MAR 8 1950

J. E. TYRA

County Ellis State Kansas

Sec. 22 (Blk. 14 (Sur. 16W (Twp. 14 (Rge. 16W Map No.

Operator Atlantic

Well No. 1 Farm Dreiling

Elev. 1892 Location SE SW NW

330 Ft. From S Line NW

990 Ft. From W Line Quarter

1st. Report DEC 20 1950

Completion DEC 20 1950

Remarks OWPB

Spudding Date W. P. B.

Drlg. Data Oil well TD 3323

Lens. 3126 Arb. 3397 TD 3422 5" @ 3406

SP 3323 30/ 3127-32 P/ 32 ho 50% water

500 A Comp. 287 bopd 10% water

J. E. TYRA

County Ellis State KansasSec. 22 (Blk.
Twp.) 14 (Sur.
Rge.) 16W Map No.Operator AtlanticWell No. 1 Farm DreilingElev. 1892 Location SE SW NW

330 Ft. From S Line NW990 Ft. From W Line Quarter1st. Report 1-11-50Completion 3-8-50Remarks Dreiling PoolSpudding Date 1-11-50Drlg. Data Oil well TD 34038" @ 230 Heeb. 3080 Tor. 3041Lans. 3146 DST 3129-59 open 1 hr.Rec. 1000' oil Cong. 3374 Arb. 3397TD 3403 5" @ 3403 P/ 108 bo 18 hr.Comp. 274 bopd 4% waterDuplicate

J. E. TYRA