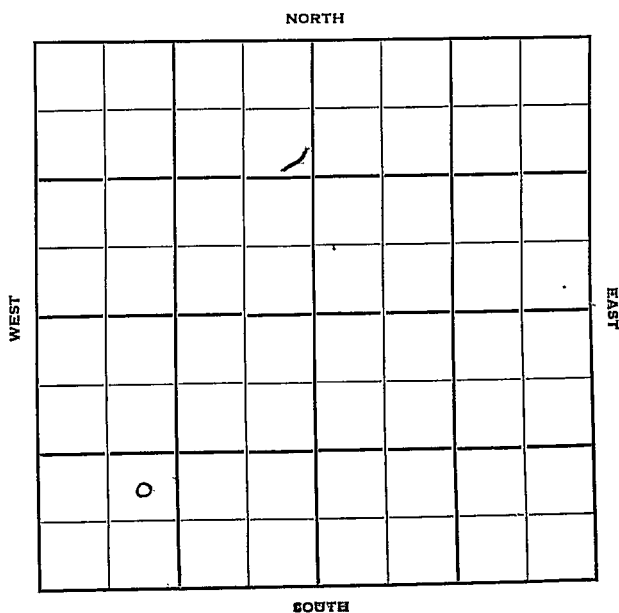


Section 22 Township 14 Range 16-WWell No. #1 Dreiling "B"Company Atlantic

Sec. 22 Twp. KANSAS R. 16-W

Well No. #1 Dreilling "B" Farm

Atlantic

Company

Armer Drlg.

Contractor

Dreilling

Ft. from N. Line

990


Ft. from S. Line

Ft. from E. Line

990

Ft. from W. Line

NE SW SW

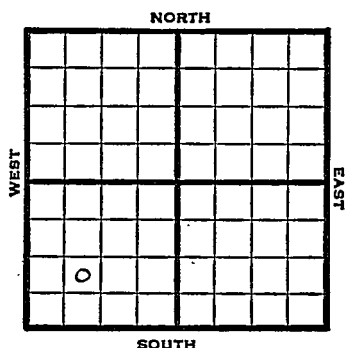

1950

Elev. 1855' REPORT

10/4

Location

12/13

Spud 110-11-50
Oil Well TD 3365'
8" @ 205' Lans. 3088'
DST 3090-3122 opn 1 hr
Rec. 60' ocm 360' ho 7 gcm
210' sw Arb. 3339'
TD 3343 5" @ 3341
DD 3357 1 goph 500 A 1 boph
2000 A S/26 bo 35 bw S/40 bw
8 bopd DD 3365
S/37 bw 20 bo 18hr 500 A
S/156 bw 25 bo 9hr
9/3120-24 16/3120-24 250 A
S/2½ bo 1½ bwph P/55 bo 25 bwph
P/26 bopd 38% wtr P/24 bo 35% wtr
Comp. 24 bopd

COMPLETED

County Ellis State Kansas

Sec. **22** (Blk. **14** (Sur. **16W** Map No.

Operator **Atlantic**

Well No. **1** Farm **Dreiling "B"**

Elev.	Location	NE	SW	SW
-------	----------	----	----	----

990 Ft. From S Line SW

990 Ft. From W Line Quarter

1st. Report OCT 4 1950

Completion

Remarks

Armer Drlg. - Contr.

Spudding Date _____

Drig. Data Dreiling Pool

Location _____

J. E. TYRA

County Ellis State Kansas
 Sec. 22 (Blk. 14) (Sur. 16W) (Twp. Map No.)
 Operator Atlantic
 Well No. 1 Farm M.P. Dreiling "B"
 Elev. 1855 Location NE SW SW

990 Ft. From S Line SW
990 Ft. From W Line Quarter
 1st. Report _____
 Completion DEC 13 1950
 Remarks Dreiling Pool
Armer Drlg. - Contr.
 Spudding Date 10-11-50

Drlg. Data Oil well TD 3365
8" @ 205 Lans. 3088 DST 3090-3122
open 1 hr. Rec. 60' ocm 360' ho & gcm
210' sw Arb. 3339 TD 3343 5" @ 3341
DD 3357 1 goph -500 A 1 boph 2000 A
S/ 26 bo 35 bw S/ 40 bw 8 bopd
DD 3365 S/ 37 bw 20 bo 18 hr. 500 A
S/ 156 bw 25 bo 9 hr. 9/ 3120-24
16/ 3120-24 250 A S/ 2 $\frac{1}{2}$ bo 1 $\frac{1}{2}$ bwph
P/ 55 bo 25 bwph P/ 26 bopd 38% water
P/ 24 bo 35% water
Comp. 24 bopd