


Section 22 Township 14 Range 16WWell No. #3 TholenCompany Glickman Oil Co.

NORTH

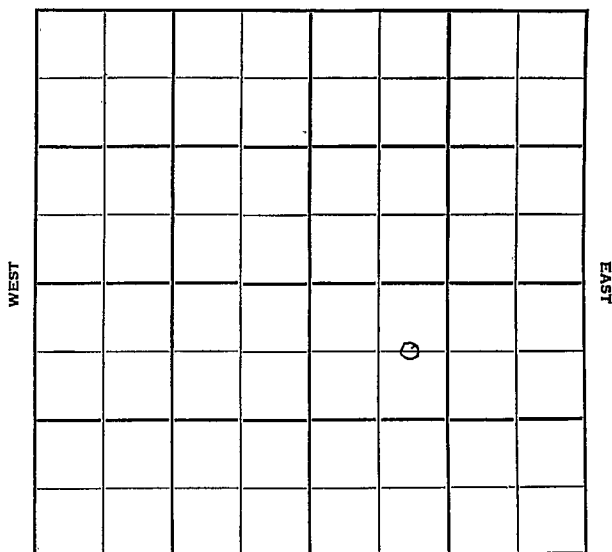

SOUTH

Ellis

KANSAS

Sec. 22 Twp. 14 R. 16 W

Well No. # 3 Tholen Farm ☒

Glickman Oil Co. Company

Veeder Supply Contractor

Dreiling Pool


660 Ft. from N. Line

_____ Ft. from S. Line

_____ Ft. from E. Line

990 Ft. from W. Line

C E L NW SE

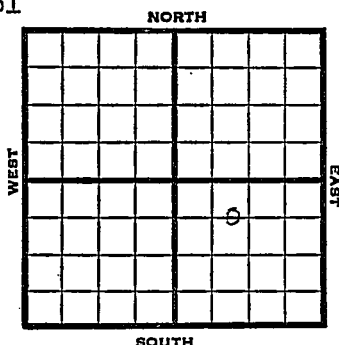

1951

Elev. 1891' REPORT


9/5

Spud 8-27-51
8" @ 224' Anhy 998'
Drilg. 2800'

10/10

Spud 8-27-51
Oil Well TD 3406
8" @224
Anhy 998
DST 2778-2810 opn 20 min.
Rec. 20' mud
Heeb. 3086 Tor. 3106
Lans. 3134
DST 3136-67 opn 1/2 hr.
Rec. 187 ho & gcm
Cong. 3378 Arb. 3401
5" @ 3401 TD 3406
GO to 3372 10/3306-10 wtr
SP 3290 30/3277-85 1/2 boph
2000 A S/6 boph 23/3136-40
46/3162-70 6000 A S/12 boph
P/95 bo 8 hr.
Comp. 205 bopd 25% wtr.

COMPLETED

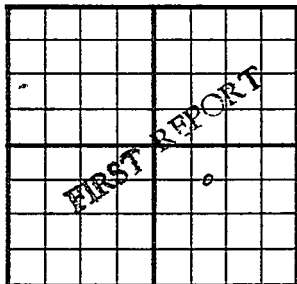
County Ellis State KansasSec. 22 (Blk.
Twp.) 14 (Sur.
Rge.) 16W Map No.Operator Glickman Oil Co.Well No. 3 Farm TholenElev. Location C E L NW SE660 Ft. From N Line SE990 Ft. From W Line Quarter1st. Report SEP 5 1951

Completion

Remarks

Veeder Supply - Contr.Spudding Date 8-27-51Drlg. Data Dreiling Pool8" @ 224 Anhy 998 drlg. 2800

County Ellis State Kansas
 Sec. 22 (Blk. 14) (Sur. 16W) Map No. _____
 Operator Glickman Oil Co.
 Well No. 3 Farm Tholen
 Elev. 1891 Location C E L NW SE

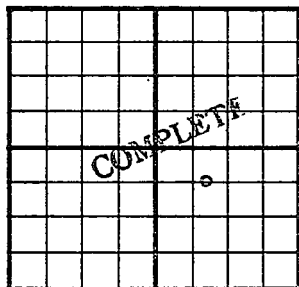

660 Ft. From N Line SE
 990 Ft. From W Line Quarter
 1st. Report OCT 10 1951
 Completion _____
 Remarks Dreiling Pool
Veeder Supply - Contr.
 Spudding Date 8-27-51

Drlg. Data Oil well TD 3406
8" @ 224 Anhy 998 DST 2778-2810
open 20 min. Rec. 20' mud Heeb. 3086
Tor. 3106 Lans. 3134 DST 3136-67
open $\frac{1}{2}$ hr. Rec. 187' ho & gcm Cong. 3378
Arb. 3401 5" @ 3401 TD 3406 CO to 3372
10/ 3306-10 water SP 3290 30/ 3277-85
 $\frac{1}{2}$ boph 2000 A S/ 6 boph 23/ 3136-40
46/ 3162-70 6000 A S/ 12 boph
P/ 95 bo 8 hr. Comp. 205 bopd 25% water

J. E. TYRA