


Section 22 Township 14 Range 16W

Well No. #3 M. P. Dreiling

Company Atlantic

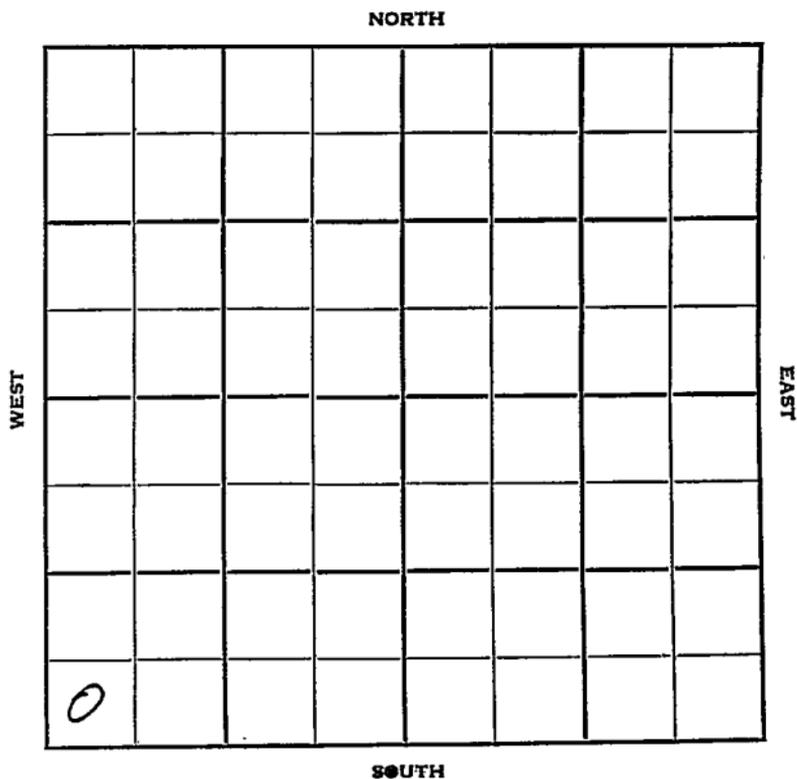

Ellis

KANSAS

Sec. 22 Twp. 14 R. 16 W

Well No. # 3 Dreiling Farm

Atlantic Company

Anschutz Drlg. Contractor

Dreiling Pool


_____ Ft. from N. Line

990 Ft. from S. Line

_____ Ft. from E. Line

330 Ft. from W. Line

NW SW NW

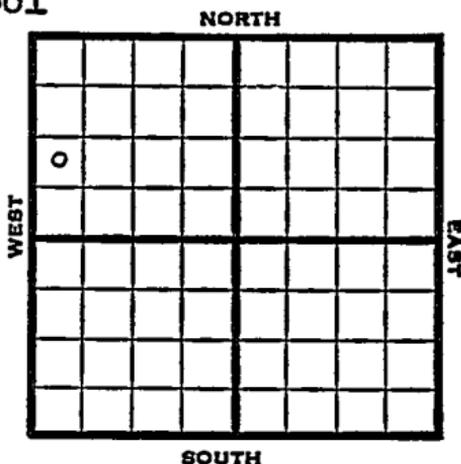

1951

Elev. 1890'

REPORT

5/23

R U R

8/1

Spud 5-23-51

Oil well TD 3400' 9" @ 196

Heeb 3085' Tor. 3102' KC 3130'

Arb. 3377'

TD 3380' 7" @ 3379

DST 3132-64 open 1 hr. rec 220' SOCM

60' water 500 A no inc. DD 3400

1000 A 2 BOPH 2000 A

Comp. 26 BOPD

COMPLETED

County Ellis State Kansas

Sec. 22 (Blk. 14) (Sur. 16W) Map No.

Operator Atlantic

Well No. 3 Farm J. P. Dreiling

Elev. 1890 Location NW SW NW

0				

990 Ft. From S Line NW

330 Ft. From W Line Quarter

1st. Report

Completion AUG 1 1951

Remarks Dreiling Pool

Anschutz Drlg. - Contr.

Spudding Date 5-23-51

Drlg. Data Oil well TD 3400

9" @ 196 Heeb. 3085 Tor. 3102

KC 3130 Arb. 3377- TD 3380 7" @ 3379

DST 3132-64 open 1 hr. Rec. 220' socm

60' water 500 A no inc. DD 3400

1000 A 2 boph 2000 A Comp. 26 bopd

J. E. TYRA