

Ellis

Section 22 Township 14 Range 16W **KANSAS**Well No. #3 DreilingCompany Atlantic

NORTH

WEST

EAST

0							

SOUTH

Ellis

KANSAS

Sec. 22 Twp. 14 R. 16 W

Well No. # 3 M. P. Dreiling Farm

Atlantic Company

Armer Contractor

Dreiling Pool


Ft. from N. Line

330 Ft. from S. Line

Ft. from E. Line

330 Ft. from W. Line

SW SW SW

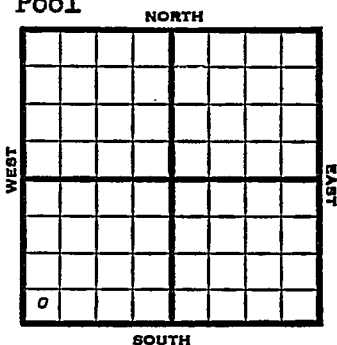

1951

Elev. 1853' REPORT

5/23

R U R

8/1

Spud 5-23-51

Oil well TD 3377' 9" @ 196

Heeb 3048' Lans 3097'

DST 3100-30 open 1 hr. rec 32' GCM

DST 3228-46 open 1 hr. rec 100' oil

150' HOCM, 960' gas

Cong. 3345' Arb. 3347-55'

7" @ 3354' TD 3377' 1000 A

1 BOPH S/10 GO PH 2000 A

S/4 BWPB SP 3324 40/3239-144

500 A S/5 BOPH

Comp. 140 BOPD 1% water

COMPLETED

County Ellis State KansasSec. 22 (Blk. Twp.) 14 (Sur. Rge.) 16W Map No.Operator AtlanticWell No. 3 Farm DreilingElev. Location NW SW NW

0							

990 Ft. From S Line NW330 Ft. From W Line Quarter1st. Report MAY 23 1951

Completion

Remarks

Anschutz Drlg. - Contr.

Spudding Date

Drlg. Data Dreiling PoolR U R

County Ellis State KansasSec. 22 (Blk.
Twp.) 14 (Sur.
Rge.) 16W Map No.Operator AtlanticWell No. 3 Farm M. P. DreilingElev. 1853 Location SW SW SW

0							

330 Ft. From S Line SW330 Ft. From W Line Quarter

1st. Report

Completion AUG 1 1951Remarks Dreiling PoolArmer - Contr.Spudding Date 5-23-51Drig. Data Oil well TD 33779" @ 196 Heeb. 3048 Lans. 3097DST 3100-30 open 1 hr. Rec. 32' gcmDST 3228-46 open 1 hr. Rec. 100' oil150' hoem 960' gas Cong. 3345Arb. 3347-55 7" @ 3354 TD 3377 1000 A1 boph S/ 10 go ph 2000 A S/ 4 bwphBP. 3324 40/ 3239-44 500 A S/ 5 bophComp. 140 bopd 1% water

J. E. TYRA