


Section 22 Township 14 Range 16 W

Well No. #2 Tholan

Company Glickman & Veeder

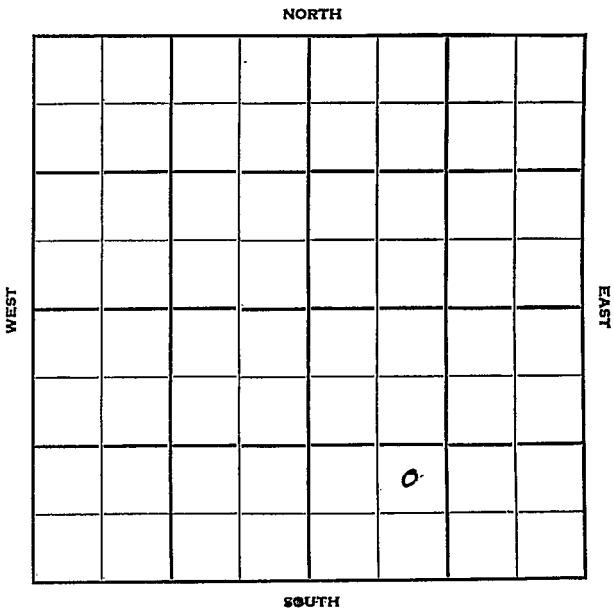

Ellis

KANSAS

Sec. 22 Twp. 14 R. 16W

Well No. #2 Tholan Farm

Glickman & Veeder Company

Contractor


\_\_\_\_\_ Ft. from N. Line

990' Ft. from S. Line

\_\_\_\_\_ Ft. from E. Line

990' Ft. from W. Line

NE SW SE

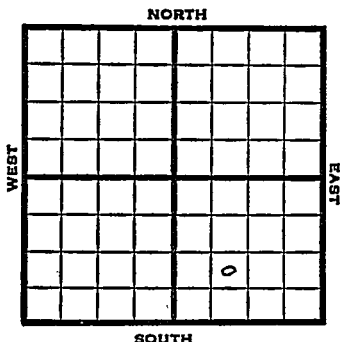

1951 Elev. 1888' REPORT

1/31 Location

3/21 Spud 2-6-51  
Oil Well TD 3399  
8" @ 216'  
Anhy 990' Top. 2866  
Heeb. 3086' Lans. 3135  
DST 3135-80 opn 1 hr  
Rec. 130' sgc  
Cong. 3380  
B/5 goph 1500 A S/5 boph  
Comp. 318 bopd  
**COMPLETED**



