

Section 22 Township 14 Range 15W

Well No. #2 Furthmeyer

Company Brussen Drlg.

NORTH

							0

WEST

EAST

SOUTH

Russell


Sec. 22 Twp. 14 R. 15W

Well No. #2 Furthmeyer Farm

Brunsen Drlg. Company

Brunsen Contractor
Gorham

_____ Ft. from N. Line
990 Ft. from S. Line
330 Ft. from E. Line
_____ Ft. from W. Line

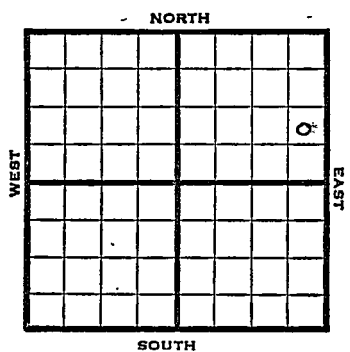

NE SE NE

1952

Elev. 1807' REPORT

1/23

Location

2/6

TD 3272
5" @ 3225, WOC

2/13

CO to 3227 S/3/4 BOPH for 6 hrs.
500 A
DO to 3228 TD test 1 BOPH
750 A HFW

2/20

Shut down

3/5

Spud 1-24-52
Temp Abnad. TD 3228
Anhy 858 8" @ 860
Heeb. 2934 Lans. 2985
Arb. 3224 TD 3227
5" @ 3225 CO to 3227
3/4 boph 6 hr. 500 A
DD 3228 1 boph 750 A HFW
Temp Aband.

ABANDONED

