

Section 22 Township 14 Range 15 WWell No. # 1 FurthmeyerCompany Brunson Drlg.

NORTH

							0

SOUTH

Russell

KANSAS

Sec. 22 Twp. 14 R. 15W

Well No. #1 Furthmeyer Farm

Brunson Drlg. Company

Contractor


990 Ft. from N. Line

 Ft. from S. Line

330 Ft. from E. Line

 Ft. from W. Line

SE NE NE

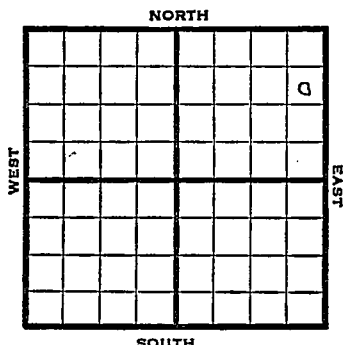

1951

Elev. 1802' REPORT


10/31

Spud 10-27-51
Rng. 8"

11/28

Spud 10-27-51
Oil Well TD 3217
Anhy 834 8" @ 854
Heeb. 2921 Lans. 2975
Arb. 3213 TD 3214
5" @ 3213 DD 3217 FU 300'
oil 1 hr. 500A
Comp. 60 BOPD

COMPLETED

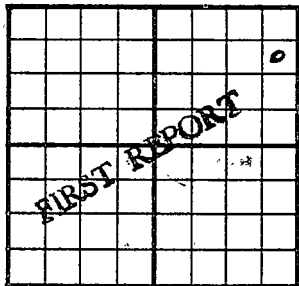County Russell State KansasSec. 22 (Blk. Twp.) 14 (Sur. Rge.) 15W Map No.Operator Brunson Drlg.Well No. 1 Farm FurthmeyerElev. Location SE NE NE990 Ft. From N Line NE330 Ft. From E Line Quarter1st. Report OCT 31 1951

Completion

Remarks

Spudding Date 10-27-51

Drlg. Data

8"

J. E. TYRA

J. E. TVRA