

Section 22 Township 14 Range 14W

Well No. #5 Boxberger "A"

Company Texas


KANSAS

Russell

Sec. 22 Twp. 14 R. 14-W ✓

Well No. #5 Boxberger "A" Farm

Texas Company

Sickle Drlg Contractor


660 Hall-Gurney
Ft. from N. Line

_____ Ft. from S. Line

330 Ft. from E. Line

_____ Ft. from W. Line

C EL NE SE

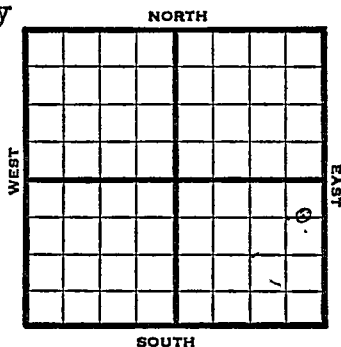

1950

Elev 1802'

REPORT

2/1

Spud 1-28-50

10"@ 809'

TD 810'

Shut down

2/22

TD 3060'

10"@ 809'

7"@ 2982'

Heeb 2897'

Br L 2958'

Lans 2983'

110 BOPD 12% Wtr.

Gomp

COMPLETED

Kansas

Hall-Gurney

Map No. _____ Sec. 22 Twp. 14 R. 14W

Well No. 5 Boxberger "A"

Texas

Company

Sickle Drlg.

Contractor

C E L N E S E


SECTION PLAT

660 Ft. from N. Line

Ft. from S. Line

330 Ft. from E. Line

Ft. from W. Line

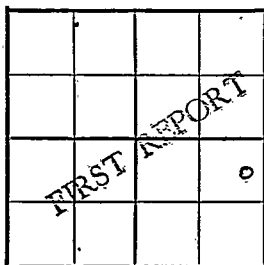

Russell County

Location

Rig up

Drilling and Remarks:

Spud 1-28-50

10" @ 809

TD 810

shut down

RECORD

Cased _____ in., _____ ft.

Sand _____

Gas _____

Oil _____

Total Depth _____

PRODUCTION

1st 24 hrs. Nat. _____

1st 24 hrs. after shot _____

Gas _____ Cu. Ft.

Dry Hole _____

Abandoned _____

Date

FEB 1 1950 19

J. E. TYRA Scout

Map No. _____ Sec. 22 Twp. 14 R. 14WWell No. 5 Boxberger "A"

_____ Texas _____ Company

_____ Contractor

C E L N E S E


E. 1802
SECTION PLAT660 Ft. from N. Line

_____ Ft. from S. Line

330 Ft. from E. Line

_____ Ft. from W. Line

Russell County

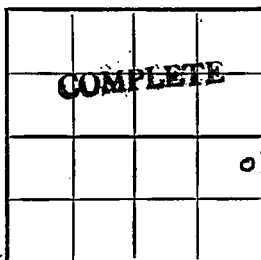

Location _____

Rig up _____

Drilling and Remarks:

10" @ 8097" @ 2982Hub 2897Br L 2958Lens 2983110 BOPD12% wtr.

RECORD

Cased _____ in., _____ ft.

Sand _____

Gas _____

Oil _____

Total Depth 3060

PRODUCTION

1st 24 hrs. Nat. _____

1st 24 hrs. after shot _____

Gas _____ Cu. Ft.

Dry Hole _____

Abandoned _____

Date

FEB 22 1950

19

J. E. TYRA Scout