


Section 22 Township 14 Range 14W

Well No. #10 Halls

Company Aylward Drlg.

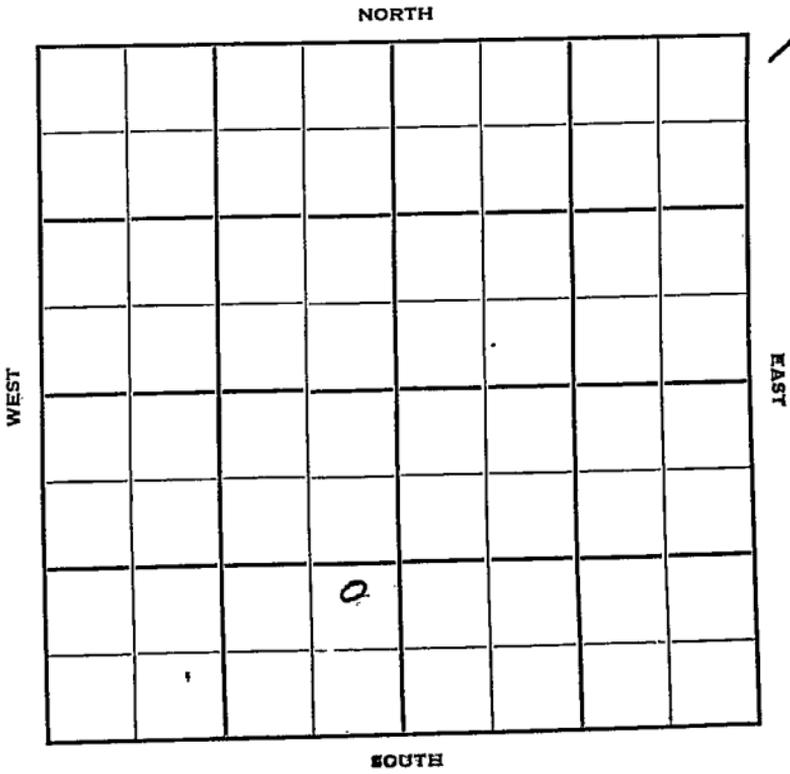

Sec. 22 Twp. 14 R. 14W

Well No. #10 Halls Farm

Aylward Drlg. Company

Aylward Drlg. Contr. Contractor
Hall-Gurney Pool

_____ Ft. from N. Line

1155'


_____ Ft. from S. Line

330'

_____ Ft. from E. Line

_____ Ft. from W. Line

NE SE SW

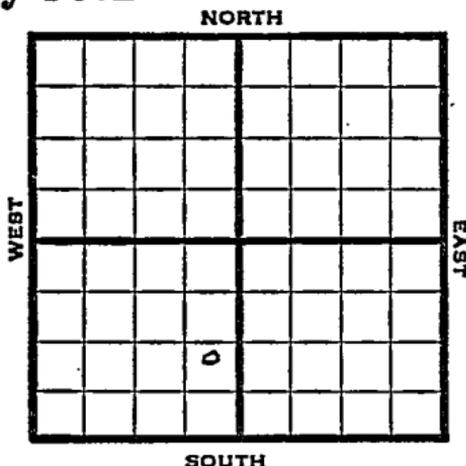

1950

Elev. 1845' REPORT

9/13

Location

10/18

Spud 9-19-50

Oil Well TD 3085'

8-5/8" @ 140'

Anhy 840' Lans. 2992'

5" @ 2997' SSO 3073-75

TD 3085'

Test 8 GOPD 6000 A

Comp. 40 BOPD

COMPLETED

