


Section 22 Township 14S Range 11W

Well No. 15 Hall

Company Aylward Drlg

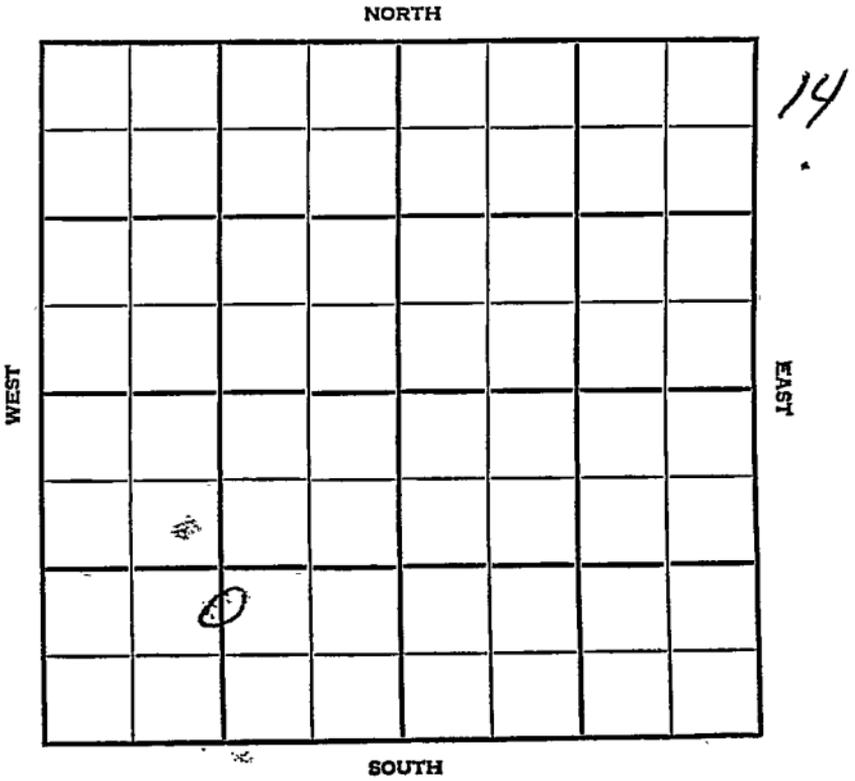

County Russell Elev. 1851 RB 1849 DF
 Sec. 22 Twp. 14 Rge. 14W
 Company Aylward Drlg.
 Farm Name Hall No. 15

TOPS	DEPTH	LOG	DATUM
Anh.	835		
Tp.			
H. Gr. Haven	2367		516
Tr. 2nd Tarkio	2401		550
Dg. 3rd Tarkio	2466		615
Bt. Harb	2937		1086
L.	2995		1144
K.C.			
B.K.C.			
Ce.			
C.			
M.			
M.			
K.			
Mz.			
Ms.			
V.			
S.			
S.			
A			
R.			
PE.			
G.			
TD.	3105		

Loc. in Sec. C N $\frac{1}{2}$ S $\frac{1}{2}$ SW

Geol. _____
 Contr. _____

Pool
 Gorham

COMPLETE

Date Comm. 4-27-55 JUN 1 1955

8" @ 250 5 $\frac{1}{2}$ " @ 2997 CO to 3105

2000 A SP 2427 23/ 2402-07

sd-frac Comp. 17 bopd @ 28% wtr.

Co.
 Lse.
 No.
 Sec.
 T.
 R.