


Section 22 Township 14 Range 14-W


Well No. 1 Hall

Company Aylward et al

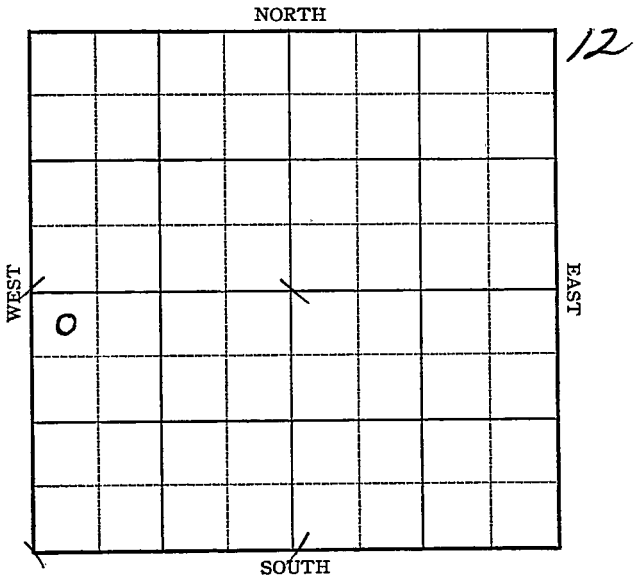

Sec. 22 Twp. 14 R. 14-WWell No. #1 Hall FarmAylward et al Company330 Ft. from N. Line Ft. from S. Line Ft. from E. Line330 Ft. from W. Line

Elev. 1873'

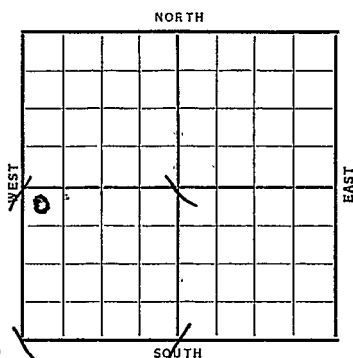

Date REPORT O. W. D. D

1938

1/12 B.C.R.

1/20 C.R.

1/28 15" - 380' 12" - 520'

Anhy 865' 10-876'

Drlg. 1020'.

2/4 Drlg. 2140'

2/11 10" @ 322'. Drlg. 1545'.

2/18 Oswald & 7" @ 3015'.

T.D. 3050'. 500' oil.

2/26 7" @ 3025'. WOC.

3/2 7" @ 3025'.

K.C. 3015'.

T.D. 3063'.

10,000 acid.

Potential 1236 bbls.

COMPLETED

OVER

O. W. D. D

1939
9/27

Old T.D. 3065'
Increase 3070-78'
Inc. 3105-15'
T.D. 3121'
7000 acid.

10/4

Inc. oil 3070-78'
Inc. oil 3105-15'
T.D. 3121'
7000 acid.
Potential 2590 bbls., pump.

COMPLETED

Map No. 72 Sec. 22 Twp. 14 R. 14WWell No. 1 HallAylward etal

Company

FIRST REPORT


Shelf farmout Contractor
SECTION PLAT

NW SW

330 Ft. from N. Line

_____ Ft. from S. Line

_____ Ft. from E. Line

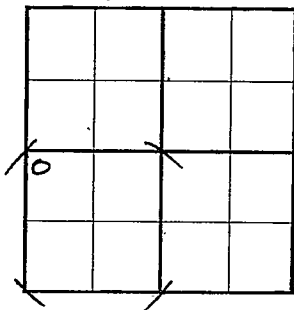330 Ft. from W. Line

Location _____

Rig up _____

Drilling and Remarks:

BCR

RECORD

Cased _____ in., _____ ft.

Sand _____

Gas _____

Oil _____

Total Depth _____

PRODUCTION

1st 24 hrs. Nat. _____

1st 24 hrs. after shot _____

Gas _____ Cu. Ft.

Dry Hole _____

Abandoned _____

Date

JAN 12 1938

19

H. D. Hatfield Scout

Russell KANSAS

Map No. _____ Sec. 22 Twp. 14 R. 14WWell No. 1 Hall_____ Aylward et al _____ Company

_____ Contractor

COMPLETED**NW SW**330 Ft. from N. Line

_____ Ft. from S. Line

_____ Ft. from E. Line

330 Ft. from W. Line**SECTION PLAT**

0			

Location _____

Rig up _____

Drilling and Remarks:

10,000 andLOT 12 36**RECORD**Cased 7 in. 3025 ft.Sand KC 3015

Gas _____

Oil _____

Total Depth 3063**PRODUCTION**

1st 24 hrs. Nat. _____

1st 24 hrs. after shot _____

Gas _____ Cu. Ft.

Dry Hole _____

Abandoned _____

Date

MAR 2 - 1938 19 H. D. Hatfield Scout

Map No. _____ Sec. 22 Twp. 14 R. 14WWell No. 1 HollAylward etal

Company

Contractor

FIRST REPORT
NW NW SW

SECTION PLAT

0			

330 Ft. from N. Line

_____ Ft. from S. Line

_____ Ft. from E. Line

330 Ft. from W. Line

ALLON POOL

Location _____

Rig up _____

Drilling and Remarks: _____

OWDD-OTD 3065

Increase

3070-78

Inc. 3105-15

T.D. 3121

7000 acid

RECORD

Cased _____ in., _____ ft.

Sand _____

Gas _____

Oil _____

Total Depth _____

PRODUCTION

1st 24 hrs. Nat. _____

1st 24 hrs. after shot _____

Gas _____ Cu. Ft.

Dry Hole _____

Abandoned _____

Date

SEP 27 1939

19

S. J. LEWIS

Scout

Map No. _____ Sec. 22 Twp. 14 R. 14W

Well No. 1 Holl

Aylward et al

Company

Contractor

COMPLETED

NW NW SW

SECTION PLAT

330 Ft. from N. Line

_____ Ft. from S. Line

_____ Ft. from E. Line

330 Ft. from W. Line

ALLON POOL

0			

Location _____

Rig up _____

Drilling and Remarks:

OWNERS

Inc oil 3070-78

Inc oil 3105-15

7000 acid

Pump 2590 P & S

RECORD

Cased _____ in., _____ ft.

Sand _____

Gas _____

Oil _____

Total Depth 3121

PRODUCTION

1st 24 hrs. Nat. _____

1st 24 hrs. after shot _____

Gas _____ Cu. Ft.

Dry Hole _____

Abandoned _____

Date

OCT 4 1939 19

S. J. LEWIS Scout