


Section 22 Township 14 Range 11W

Well No. #14 Hall

Company Aylward Drlg.

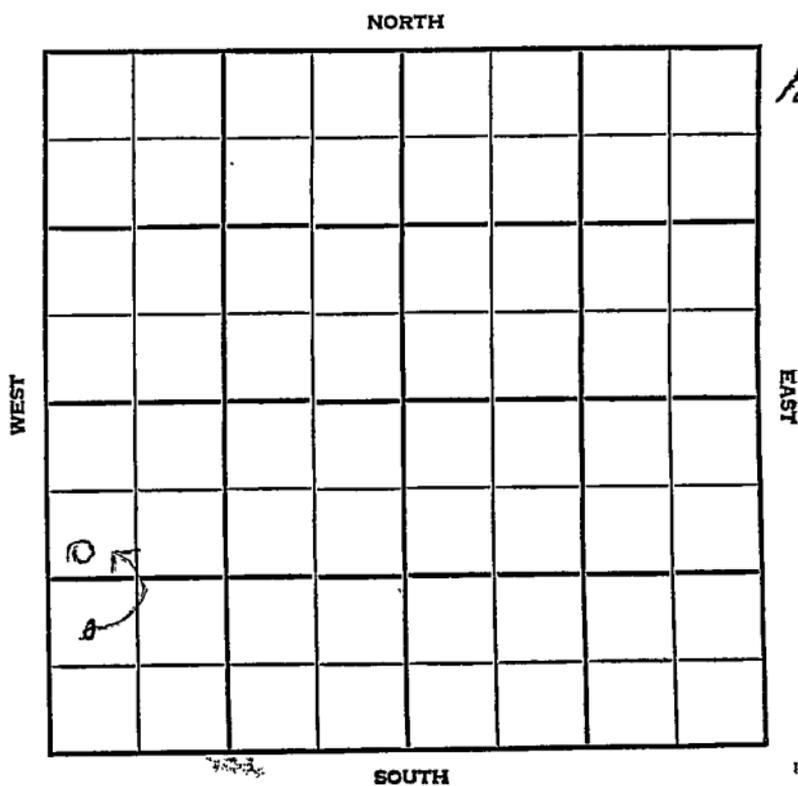

Russell KANSAS

SEC.	TWP.	R.
22	14	14 W

WELL NO. # 14 Hall FARM

COMPANY Aylward Drlg.

CONTRACTOR Co. tools


Russell Pool

_____ Ft. from N. Line

~~990~~ 1500 _____ Ft. from S. Line

_____ Ft. from E. Line

330 _____ Ft. from W. Line

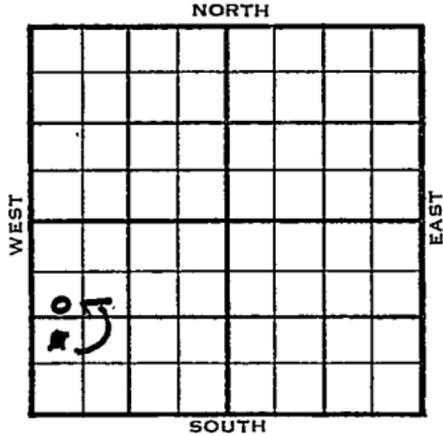

1955	ELEVATION	REPORT
	1845'	

2/23 MIR
 3/23 Spud 2-21-55, Oil Well; TD 2422
 8" @ 50, 2nd Tarkio, 2396,
 TD 2422, 4" @ 2421, CO 27/
 2396-2402, FU 90' oil, 12 hr,
 frac S/10 BOPH
 Comp 25 BOPD

COMPLETED

SCOUT TICKET

DX-201

Kansas

SEC.	TWP.	R.
22	14	14W

WELL NO. 14 Hall FARM

COMPANY Aylward Drlg.

CONTRACTOR CORRECTION


SW NW SW

_____ FT. FROM N. LINE

1500 FT. FROM S. LINE

_____ FT. FORM E. LINE

330 FT. FROM W. LINE

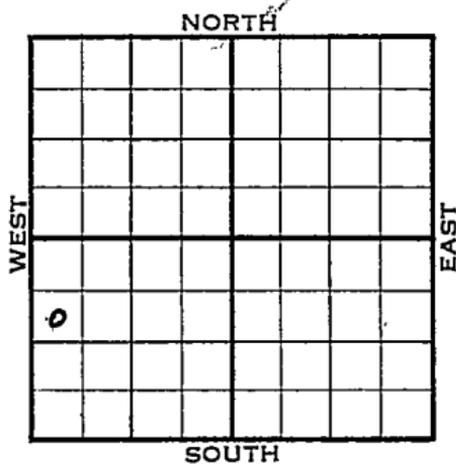

Russell County

LOCATION

RIG UP

DRILLING AND REMARKS:

Reported

NW SW SW

RECORD	CASED	IN.,	FT.
	SAND		
	GAS		
	OIL		
PRODUCTION	TOTAL DEPTH		
	1ST 24 HRS. NAT.		
	1ST 24 HRS. AFTER SHOT		
	GAS		CU. FT.
	DRY HOLE		
	ABANDONED		

DATE MAR 2 1955 SCOUT FABEN GILSTRAP

County Russell State Kansas

Sec. 22 (^{Blk.} ^{Twp.}14) (^{Sur.}14W ^{Rge.}) Map No.

Operator Aylward Drlg.

Well No. 14 Farm Hall

Elev. 1845 Location SW NW SW

1500 Ft. From S Line SW

330 Ft. From W Line Quarter

Ist. Report

Completion MAR 23 1955

Remarks Russell Pool

Co. tools

Spudding Date 2-21-55

Drlg. Data Oil well TD 2422

8" @ 50 2nd Tarkio 2396 TD 2422

4" @ 2421 CO 27/ 2396-2402 FU 90' oil

-12 hr. frac S/ 10 boph.

Comp. 25 bopd.

FABEN GILSTRAP