

Section 22 Township 14 Range 14 W

Well No. # 13 Holl

Company Aylward Drlg.

NORTH

WEST

EAST

SOUTH

KANSAS

SEC.

TWP.

R.

22

71

U, W

WELL NO.

13 Holl

FARM

COMPANY

Aylward Drlg.

CONTRACTOR

Anschutz

Hall-Gurney Pool

NORTH


990 Ft. from N. Line

Ft. from S. Line

Ft. from E. Line

330 Ft. from W. Line

SW NW SW

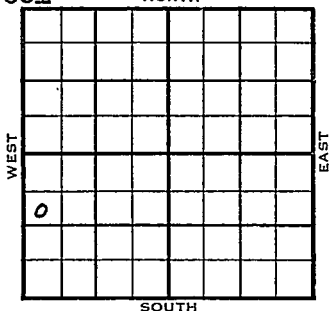

1954

ELEVATION

1865'

REPORT

8/11

Spud 7-29-54

Anhy 855 TD 2456

4" @ 2456 CO

8/25

Spud 7-29-54 - Oil Well

TD 2456'

Anhy 855', Tarkio 2396'

TD 24561

4" @ 2456'

CO to 2430' 25/2417-21

Hydro. S/40 bo 8 hrs.

Comp. 25 bopd

COMPLETED

FABEN GILSTRAP