


Section 23 Township 14 Range 15 W

Well No. # 1 Amos

Company Brunson Drlg.

O.W.W.O.

NORTH

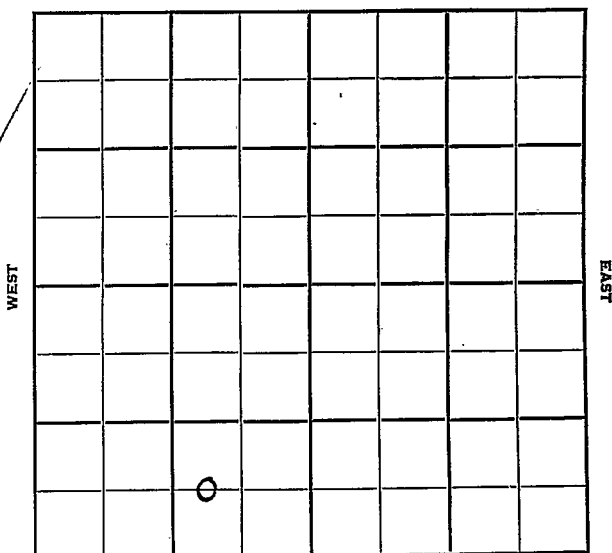

SOUTH

✓

Russell

KANSAS

Sec. 23 Twp. 14 R. 15 W

Well No. # 1 Amos Farm

Brunson Drlg. Company

Contractor

Gorham Pool


O.W.W.O. NORTH

Ft. from N. Line

660 Ft. from S. Line

990 Ft. from E. Line

Ft. from W. Line

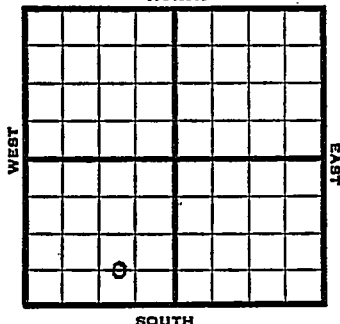

C W L SE SW

Phillips farmout

1951 Elev. 1793' REPORT

3/7 Spud 3-2-51

Anhy 846

8" @ 484

Drlg. 1900'

3/21 Spud 3-2-51

D&A TD 3229

Anhy 846'

8" @ 484

Heeb. 2917'

Lans. 2773

DST 3157-64 opn $\frac{1}{2}$ hr

Rec. 5' mud

Sand 3212-14 5" @ 3212

TD 3229 FU 500' oil 300' water 24 hr

S/1 boph 1 bwph SP 3180

12/3161-65 1000 A D&A

ABANDONED

O.W.W.O.

Oil Well TD 3229'


Granite sand 3212 TD 3229

Sq. off 3161-65 CO to 3229

Comp. 22 BO 10 bwph

FIRST REPORT

COMPLETED

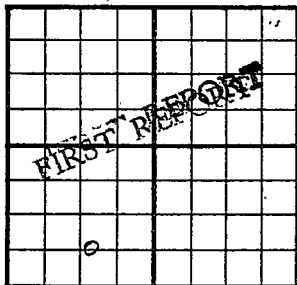
County Russell State KansasSec. 23 (Blk. Twp.) 14 (Sur. Rge.) 15W Map No. _____Operator Brunson Drlg.Well No. 1 Farm AmosElev. _____ Location C W L SE SW660 Ft. From S Line SW990 Ft. From E Line Quarter1st. Report MAR 7 1951

Completion _____

Remarks Phillips farmoutSpudding Date 3-2-51Drlg. Data Gorham PoolAnhy 846 8" @ 484 drlg. 1900

J. E. TYRA

J. E. TYRA

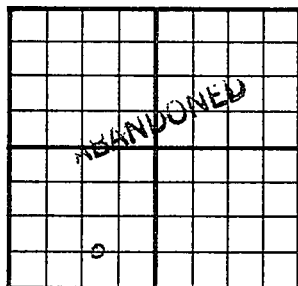County Russell State KansasSec. 23 (Blk.
Twp.) 14 (Sur.
Rge.) 15W Map No.Operator Brunson Drlg.Well No. 1 Farm AmosElev. 1793 Location C W L SE SW660 Ft. From S Line SW990' Ft. From E Line Quarter1st. ReportCompletion MAR 21 1951Remarks Gorham PoolSpudding Date 3-2-51Drlg. Data D & A TD 3229Anhy 846 8" @ 484 Heeb. 2917Lans. 2773 DST 3157-64 open $\frac{1}{2}$ hr.Rec. 5' mud Sand 3212-14 5" @ 3212TD 3229 FU 500' oil 300' water 24 hr.S/ 1 boph 1 bwph SP 3180 12/ 3161-651000 A D & A

J. E. TYRA