

KANSAS

Russell

Section 23 Township 14 Range 15W

Well No. #2 Benso


Company Texas

NORTH

WEST

EAST

SOUTH

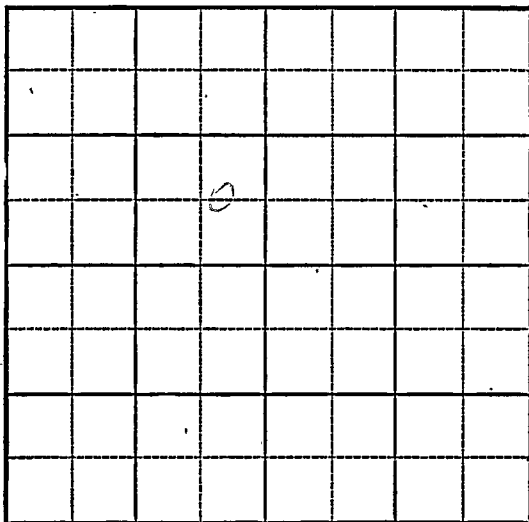

KANSAS


Russell

Sec. 23 Twp. 14 R. 15W

Well No. #2 Benso Farm
Texas Company

Big Creek

NORTH

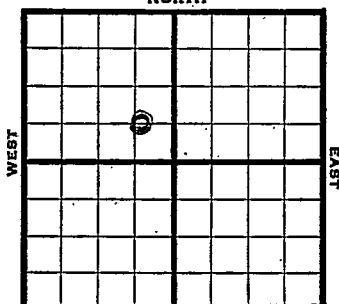

 Ft. from N. Line

660 Ft. from S. Line

510 Ft. from E. Line

 Ft. from W. Line

CSE NW 61 1757 SOUTH

1944

REPORT

8/23	Location
8/30	RUR
9/8	Anhy 785 8" @ 797 Drlg. 1900
9/13	Drlg. 2984
9/21	Lans 2933 Arb 3176 5" @ 3200 TD RUST
9/28	4 shots 3189-92 2100' oil plus 100' wtr. to squeeze
10/4	42 shots 3165-83 200 oil 500 acid
10/11	" " " " " "
10/18	Lans 2933 " " " Arb. 3176 5" @ 3200 4 shots 3189-92 42 " 3165-83 500 acid Pump 86 oil plus 28% wtr Pot. TD 3200 Grav. 32.7

COMPLETED

Pool Name Big CreekMap No. KANS 72 Sec. 23 Twp. 14 R. 15WWell No. 2 BensoTexas

Company

FIRST REPORT

Contractor

C SE NW**SECTION PLAT**

	o		

 Ft. from N. Line660 Ft. from S. Line510 Ft. from E. Line Ft. from W. LineRussell CountyLocation XRig up

Drilling and Remarks:

RECORDCased in., ft.Sand Gas Oil Total Depth **PRODUCTION**1st 24 hrs. Nat. 1st 24 hrs. after shot Gas Cu. Ft.Dry Hole Abandoned

Date

AUG 23 1944 19S. J. LEWIS

Scout

Pool Name Dig Creek PoolKANSAS
Map No. 72 Sec. 23 Twp. 14 R. 15WWell No. 2 BensoTexas


Company

COMPLETED

Contractor

C SE NW

SECTION PLAT

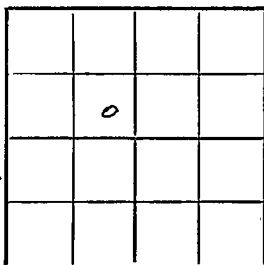 Ft. from N. Line660 Ft. from S. Line510 Ft. from E. Line Ft. from W. LineRussell CountyLocation Rig up

Drilling and Remarks:

ds on 2933Co X 31765" @ 32004 shots 3188-9242 " 3165-83500 acidPump Floe 1 + 28%80%

Date

322/42

RECORD

Cased in., ft.Sand Gas Oil Total Depth 3200

PRODUCTION

1st 24 hrs. Nat. 1st 24 hrs. after shot Gas Cu. Ft.Dry Hole Abandoned OCT 1 8 1944 19S. J. LEWIS Scout