

Section 23 Township 14 Range 15W

Well No. #5 Benso

Company Brunson Drlg.

NORTH

✓	0								

WEST

EAST

SOUTH

C

Russell

KANSAS
15W

Sec. 23 Twp. 14 R. 1

Well No. #5 Benso Farm

Brunson Drlg. Company

Brunson Drlg. - Contr. Contractor


Ft. from N. Line

990' Ft. from S. Line

Ft. from E. Line

330' Ft. from W. Line

NW SW NW

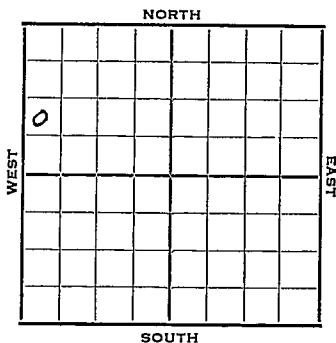

1952 Elev. 1789' REPORT

2/20 MIT
3/5 Heeb 2910'
Lans. 2964'
Arb. 3201'
RTD 3203'
5" @ 3202' WOC
3/12 Spud 2-21-52
Oil Well TD 3203 8" @ 836
Heeb. 2910 Lans. 2964
Arb. 3201
TD. 3203 5" @ 3202 S/ 1 1/2 boph
250A Comp. 50 bopd

COMPLETED

County **Russell** State **Kansas**

Sec. **23** (Blk.) **14** (Sur.) **15W** Map No.

Operator **Brunson Drlg.**

Well No. **5** Farm **Benso**

Elev. Location **NW SW NW**

0					

990 Ft. From **S** Line **NW**

330 Ft. From **N** Line Quarter

1st. Report **FEB 29 1952**

Completion

Remarks
Brunson Drlg. - Contr.

Spudding Date

Drlg. Data

M I T

County Russell State

Sec. 23 (Blk.) (Twp.) 14 (Sur.) (Rge. 15W) Map No.

Operator Brunson Drlg.

Well No. 5 Farm Benso

Elev. 1789 Location NW SW NW

990 Ft. From S Line NW

330 Ft. From W Line Quarter

Ist. Report

Completion MAR 1 2 1952

Remarks

Brunson Drlg. - Contr.

Spudding Date 2-21-52

Drlg. Data Oil well TD 3203

8" @ 836 Heeb. 2910 Lans. 2964

Arb. 3201 TD 3203 5" @ 3202 S/ 1 1/2 boph

250 A Comp. 50 bopd

COMPLETE