

KANSAS

FORM 51 5M 4-41 PETROL


Russell

Section 23 Township 14 Range 15-W

Well No. #1 Neidenthal

Company Sherman et al

NORTH Big Creek Pool

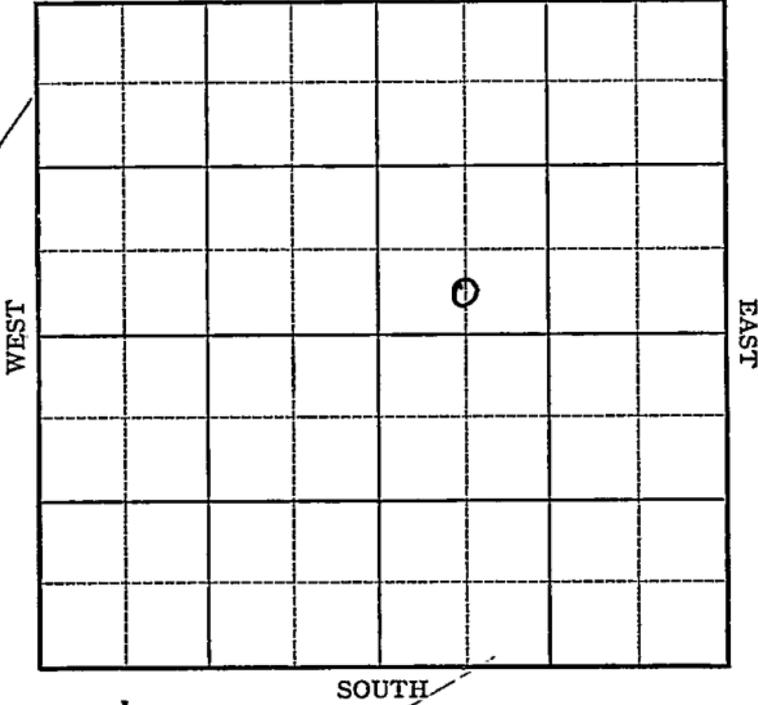

Sec. 23 Twp. 14 R. 15-W

Well No. #1 Neidenthal Farm

Sherman et al Company

(Big Creek)


_____ Ft. from N. Line

330 Ft. from S. Line

_____ Ft. from E. Line

660 Ft. from W. Line

Elev. 1757

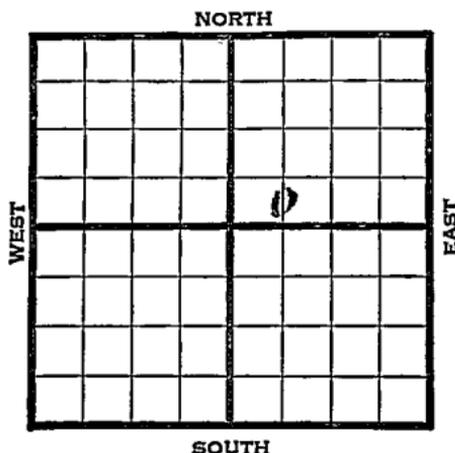

1941	REPORT
5/21	Location
5/27	"
6/5	"
6/12	"
6/19	"
6/26	"
7/3	8" - 802' WOC.
7/10	Lans. 2929' Drig. 3006'
7/17	Gorham 3166' 5" - 3166'
	T.D. 3178' 150' oil.
7/24-	TD 3182 4" liner at 3171 Temp Pot
	15 bbls.
7/31	" " " "
8/7	" " " "
8/15	" " " "

OVER

1941
8/20

Gorham 3166'

4" - 3171'

T.D. 3182'

Potential 52 bbls., pump.

35.5 Gravity

COMPLETED

Map No. 72 Sec. 23 Twp. 14 R. 15W

Well No. 1 Neidenthal

Sherman et al Company

COMPLETED Contractor

C S L SW NE

_____ Ft. from N. Line

330 Ft. from S. Line

_____ Ft. from E. Line

660 Ft. from W. Line

BIG CREEK POOL

SECTION PLAT

RECORD

Location _____

Cased _____ in., _____ ft.

Rig up _____

Sand _____

Drilling and Remarks:

Gas _____

Oil _____

Total Depth 3182

*See same 8166
4" @ 3171
Pump. 520 ft.*

PRODUCTION

1st 24 hrs. Nat. _____

1st 24 hrs. after shot _____

Gas _____ Cu. Ft.

Dry Hole _____

Abandoned _____

355 gr.

Date

AUG 20 1941

S. J. LEWIS Scout