

Russell

FORM 51 5M PETROL


**KANSAS**

Section 23 Township 14 Range 15W

Well No. #3 Neidenthal

Company Fred Smith etal

NORTH

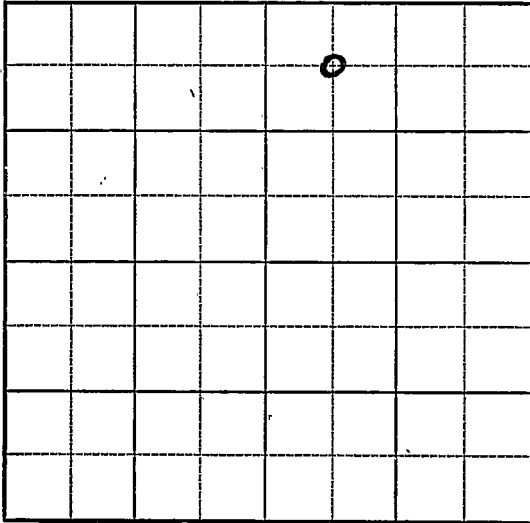

SOUTH

KANSAS

Russell

Sec. 23 Twp. 14 R. 15W

Well No. #3 Neidenthal Farm

Fred Smith et al. Company

Trapp


660 Ft. from N. Line

\_\_\_\_\_ Ft. from S. Line

\_\_\_\_\_ Ft. from E. Line

660 Ft. from W. Line

*Elev. 1817*

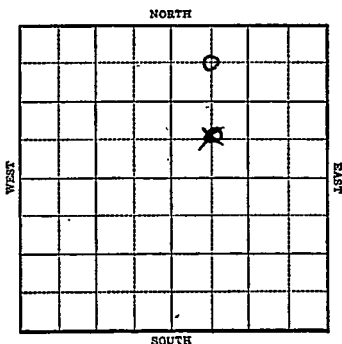

R E P O R T

1944

- 2/23 Cellar
- 3/3 Mach
- 3/8 "
- 3/16 Rigging up.
- 3/22 SD
- 3/29 Spud
- 4/5 "
- 4/12 Drlg. 760
- 4/19 1545 Drlg.
- 4/26 Drlg. 1685
- 5/3 8" @ 2450  
Drlg. 2475
- 5/10 15 1/2" @ 42' anhy 852  
8" @ 2510  
Topeka 2685  
Drlg. 2750'
- 5/17 Lans. 2985  
Show oil 3008-15  
7" - 2990  
Drlg. 3015

**OVER**

**KANSAS**

Map No. 72 Sec. 23 Twp. 14 R. 15W

Well No. 3 Neidenthal

Fred Smith et al. Company

**FIRST REPORT**

Contractor

**C NW NE**

**SECTION PLAT**

660 Ft. from N. Line

\_\_\_\_\_ Ft. from S. Line

\_\_\_\_\_ Ft. from E. Line

660 Ft. from W. Line

		o	
			i

**Trapp Pool**

Location \_\_\_\_\_

Rig up \_\_\_\_\_

Drilling and Remarks:

**Cellar**

**RECORD**

Cased \_\_\_\_\_ in., \_\_\_\_\_ ft.

Sand \_\_\_\_\_

Gas \_\_\_\_\_

Oil \_\_\_\_\_

Total Depth \_\_\_\_\_

**PRODUCTION**

1st 24 hrs. Nat. \_\_\_\_\_

1st 24 hrs. after shot \_\_\_\_\_

Gas \_\_\_\_\_ Cu. Ft.

Dry Hole \_\_\_\_\_

Abandoned \_\_\_\_\_

Date

FEB 23 1944 19

S I LEWIS Scout

Pool Name TrappMap No. KANSAS 2 Sec. 23 Twp. 14 R. 15WWell No. 3 NeidenthalFred Smith et al. CompanyCOMPLETED Contractor

C NW NE

## SECTION PLAT

660 Ft. from N. Line         Ft. from S. Line         Ft. from E. Line660 Ft. from W. Line

		o	

Russell County

Location                                 Rig up                                 

Drilling and Remarks:

*Art 3234**5" 3234**500 cu ft**Prof 391 Pt.**322 gr*

## RECORD

Cased          in.,          ft.Sand                                 Gas                                 Oil                                 Total Depth 3227

## PRODUCTION

1st 24 hrs. Nat.                         1st 24 hrs. after shot                         Gas                          Cu. Ft.Dry Hole                         Abandoned                         

Date

JUL 5 1944 19S. J. LEWIS Scout

1944

5/24 Drlg. 3215

5/31 Arb. 3227-30 TD  
5" @ 3215  
1500 oil in 7 hrs.

6/7 Arb. 3234 corrected  
5" @ 3234 TD 3237-500 acid.

6/15 Swb 30 oil in 5 hrs.

6/21 " " " " "

7/5 5" @ 3234  
Arb. 3234  
TD 3237  
500 acid  
Pump 391 Pot.  
32.7 Gravity

**COMPLETED**