

KANSAS


Russell County

Section 23 Township 14 Range 15W

Well No. #5 Neidenthal

Company Fred Smith et al

NORTH

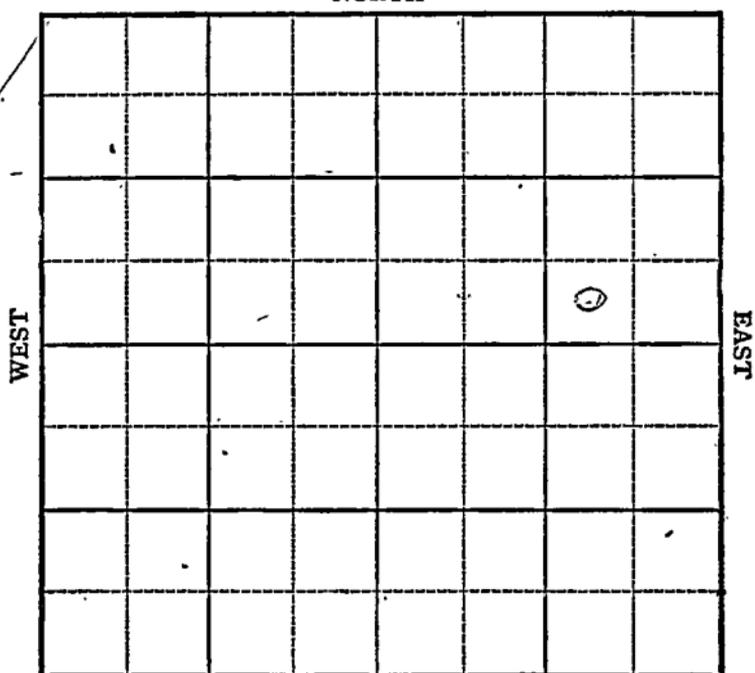

SOUTH



Sec. 23 Twp. 14 R. 15W

Well No. 5 Neidenthal Farm

Fred Smith et al Company

SW SE NE


NORTH

\_\_\_\_\_ Ft. from N. Line

370 Ft. from S. Line

990 Ft. from E. Line

\_\_\_\_\_ Ft. from W. Line

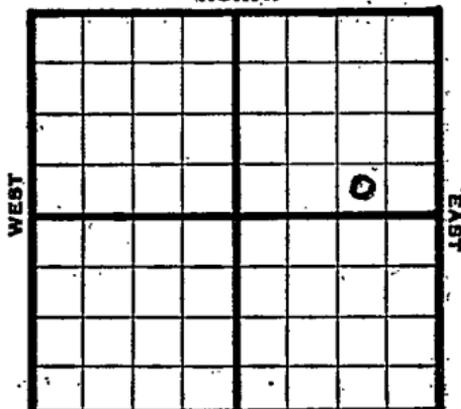

*to Sec. 1797*

1944

REPORT

9-13 Rotary

9/21 Drlg. 425'

9/28 Anhy 832

8-5/8" @ 844' Drlg. 3150

10/4 Arb 3206-07 TD  
5" @ 3207 RUST

10/11 " " " " "

10/18 " " " " "

10/25 TD 3208 500 acid 2700' oil

11/1 Arb. 3206  
5" @ 3207  
500 acid  
TD 3208  
Depth Pot. 674  
Grav. 36.4

COMPLETED

KANSAS

Pool Name Big CreekMap No. 72 Sec. 23 Twp. 14 R. 15WWell No. 5. NeidenthalFred Smith et al.

Company

FIRST REPORT

Contractor

SW SE NE

## SECTION PLAT

       Ft. from N. Line370 Ft. from S. Line990 Ft. from E. Line       Ft. from W. Line

			o

Russell County

Location       Rig up       

Drilling and Remarks:

Rotary

## RECORD

Cased        in.,        ft.Sand       Gas       Oil       Total Depth       

## PRODUCTION

1st 24 hrs. Nat.       1st 24 hrs. after shot       Gas        Cu. Ft.Dry Hole       Abandoned       

Date

SEP 13 1944 19

S. J. LEWIS

Scout

Pool Name Big CreekMap No. 72 Sec. 23 Twp. 14 R. 15WWell No. 5 NeidenthalFred Smith et al.

Company

**COMPLETED**

Contractor

SW SE NE

## SECTION PLAT

\_\_\_\_\_ Ft. from N. Line

370 Ft. from S. Line990 Ft. from E. Line

\_\_\_\_\_ Ft. from W. Line


Rus ~~se~~ 11 County

## RECORD

Location \_\_\_\_\_

Cased \_\_\_\_\_ in., \_\_\_\_\_ ft.

Rig up \_\_\_\_\_

Sand \_\_\_\_\_

Drilling and Remarks:

Gas \_\_\_\_\_

Cor 3206

Oil \_\_\_\_\_

5" 3207Total Depth 32085000 acDepth 28674

## PRODUCTION

1st 24 hrs. Nat. \_\_\_\_\_

1st 24 hrs. after shot \_\_\_\_\_

Gas \_\_\_\_\_ Cu. Ft.

Dry Hole \_\_\_\_\_

Abandoned \_\_\_\_\_

Date

NOV 1 1944 19

S. J. LEWIS

Scout