

Section 23 Township 14 Range 15WWell No. #11 Neidenthal TwinCompany Tom Palmer Oil


Big Creek Pool

NORTH

WEST

EAST

SOUTH

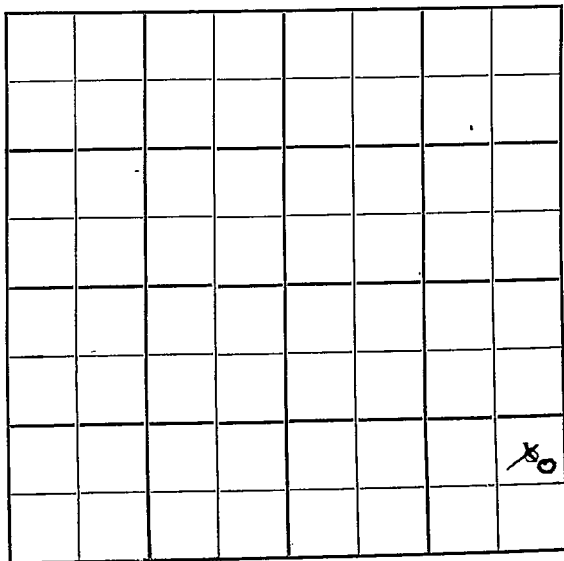

Russell

KANSAS

Sec. 23 Twp. 14 R. 15W ✓

Well No. #11 Neidenthal Farm

Tom Palmer Oil

Big Creek Pool (Palmer, Contr.) Company

950' Ft. from N. Line

990'


Ft. from S. Line

330'

290' Ft. from E. Line

Ft. from W. Line

NE SE SE

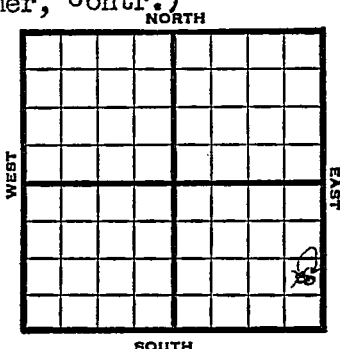

1949	Elev 1756' REPORT
12/21	Drlg. 850'
12/28	8"@ 805'
	Lansing 2930'
	Drlg 3000(
1950	
1/11	TD 3171'
	8"@ 805'
	5"@ 3169'
	Lan 2930-3000
	Arb. 3168'
	PP 50 BOPD
	Comp
	COMPLETED

Kansas

Big Creek Pool

Map No. _____ Sec. 23 Twp. 14 R. 15W

Well No. 11 Neidenthal

Tom Palmer Oil

Company

Palmer

Contractor

NE SE SE

FIRST REPORT
SECTION PLAT

			o

_____ Ft. from N. Line

990 _____ Ft. from S. Line

330 _____ Ft. from E. Line

_____ Ft. from W. Line

Russell County

Location _____

Rig up _____

Drilling and Remarks:

drig. 850

RECORD

Cased _____ in., _____ ft.

Sand _____

Gas _____

Oil _____

Total Depth _____

PRODUCTION

1st 24 hrs. Nat. _____

1st 24 hrs. after shot _____

Gas _____ Cu. Ft.

Dry Hole _____

Abandoned _____

Date

DEC 21 1939 19

S. J. LEWIS

Scout

Kansas

Map No. _____ Sec. 23 Twp. 14 R. 15WWell No. 11 Neidenthal

Tom Palmer

Company

CORRECTION

Contractor

NE SE SE

SECTION PLAT

			o

_____ Ft. from N. Line

950 Ft. from S. Line290 Ft. from E. Line

_____ Ft. from W. Line

Russell County

Location _____

Rig up _____

Drilling and Remarks:

twin to #12

Reported

990 x 330

RECORD

Cased _____ in., _____ ft.

Sand _____

Gas _____

Oil _____

Total Depth _____

PRODUCTION

1st 24 hrs. Nat. _____

1st 24 hrs. after shot _____

Gas _____ Cu. Ft.

Dry Hole _____

Abandoned _____

Date

DEC 28 1949

19

S. J. LEWIS

Scout

Kansas


Big Greek Pool

Map No. _____ Sec. 23 Twp. 14 R. 15WWell No. 11 Neidenthal

Tom Palmer Oil. _____ Company

Contractor

NE SE SE

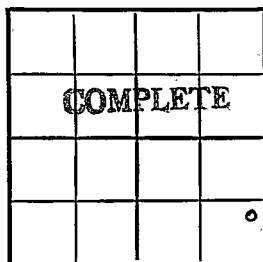Elev. 1756
SECTION PLAT

_____ Ft. from N. Line

950 Ft. from S. Line290 Ft. from E. Line

_____ Ft. from W. Line

Russell County

Location _____

Rig up _____

Drilling and Remarks:

8" @ 805
 5" @ 3169
 Log 2930-3000
 Arb 3168
 PP 50 BOPD

RECORD

Cased _____ in., _____ ft.

Sand _____

Gas _____

Oil _____

Total Depth 3171

PRODUCTION

1st 24 hrs. Nat. _____

1st 24 hrs. after shot _____

Gas _____ Cu. Ft.

Dry Hole _____

Abandoned _____

Date

JAN 11 1939 19

J. E. TYRA

Scout