

KANSAS

Russell

Section 23 Township 14 Range 15W

Well No. 8 Neidenthal

Company Palmer Oil

Big Creek
NORTH

								o	

SOUTH

Sec. 23 Twp. 14 R. 15W ✓

Well No. #8 Neidenthal Farm

Palmer Oil Company


Big Creek (Palmer, Cont.)
Pool

330' Ft. from N. Line

 Ft. from S. Line

330' Ft. from E. Line

 Ft. from W. Line

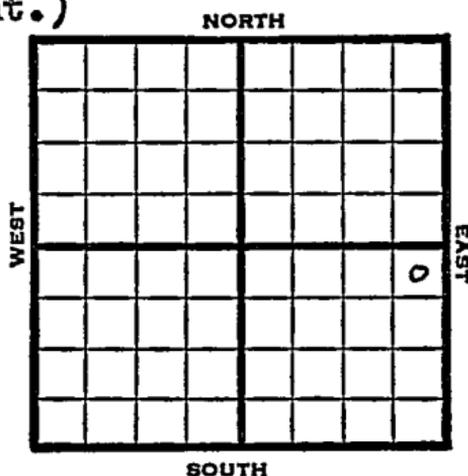

NE SE

1949 Elev 1771' REPORT

7/13 8" @ 817'
7/20 DrLg 2810'
7/27 Lansing 2936'
Arb. 3172-74'
TD 3174'
5" @ 3173'
8/3 "
8/10 TD 3178'
2200' oil 12 hrs.
8/17 TD 3178'
Arb. 3172'
5" @ 3173'
Pump 100 oil Pot
32° Gr.
Comp

COMPLETED

Kansas

Big Creek Pool

Map No. _____ Sec. 23 Twp. 14 R. 15WWell No. 8 Neidenthal

Palmer Oil _____ Company

Palmer _____ Contractor

NE SE

FIRST REPORT
SECTION PLAT330 _____ Ft. from N. Line

_____ Ft. from S. Line

330 _____ Ft. from E. Line

_____ Ft. from W. Line

Russell County

Location _____

Rig up _____

Drilling and Remarks:

8" @ 817

RECORD

Cased _____ in., _____ ft.

Sand _____

Gas _____

Oil _____

Total Depth _____

PRODUCTION

1st 24 hrs. Nat. _____

1st 24 hrs. after shot _____

Gas _____ Cu. Ft.

Dry Hole _____

Abandoned _____

Date

JUL 13 1949 19S. J. LEWIS Scout

Kansas

Map No. K 72 Sec. 23 Twp. 14 R. 15WWell No. 8 Neidenthal

Palmer Oil Company


COMPLETE

Contractor

NE SE

E. 1771

SECTION PLAT

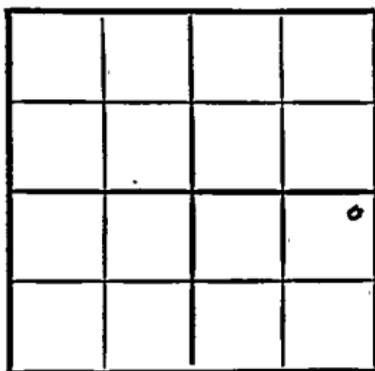330 Ft. from N. Line Ft. from S. Line330 Ft. from E. Line Ft. from W. Line

Russell County

RECORD

Location _____

Cased _____ in., _____ ft.

Rig up _____

Sand _____

Drilling and Remarks:

Gas _____

Oil _____

Total Depth 3175Cr 731725" @ 3173Pump 100 oil Rod

PRODUCTION

1st 24 hrs. Nat. _____

1st 24 hrs. after shot _____

Gas _____ Cu. Ft.

Dry Hole: _____

Abandoned: _____

32 3/4

Date

AUG 17 1949 19 S. J. LEWIS Scout