


Map No. KANSAS Sec. 23 Twp. 14 R. 14 WWell No. 1 Hurney Farm
Hartman & Blair Company

NORTH

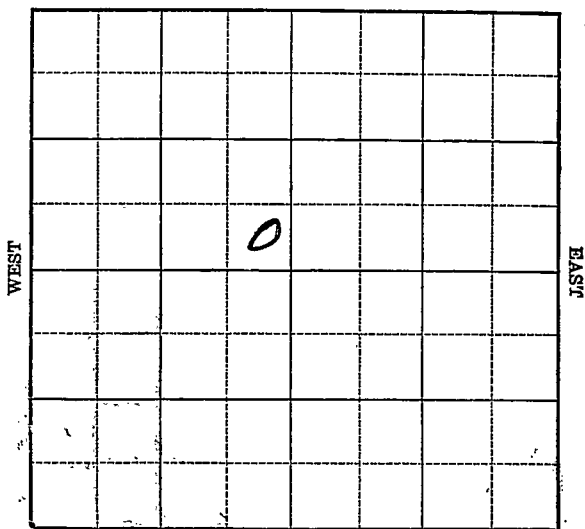

SOUTH

O. W. D. D

Location _____

Drilling Remarks _____

Rig Up _____

Drilling Remarks _____

RECORD

Cased _____ in. _____ ft.

Sand _____

Gas _____

Oil _____

Total Depth _____

PRODUCTION

1st 24 hrs. Nat. _____

1st 24 hrs. after shot _____

Gas _____ cu. ft.

Dry Hole _____

Abandoned _____

Russell

Map No. KANSAS Sec. 23 Twp. 14 R. 14WWell No. 1 Gurney Farm
Hartman & Blair Company

NORTH

WEST

EAST

SOUTH

Ft. from N. Line

330 Ft. from S. Line330 Ft. from E. Line

Ft. from W. Line

Date

REPORT

O. W. D. D

10/31 Location
11/8 11/15
11/32 Bldg. Rig
11/28
12/6 Rig
12/13 12/21
12/27 51 300
1/3/35 Bldg 770 15" 290 12" 475
1/19 " 1640 10" 800
1/17 S. g. 1685 S.O. - 2363-69
1/24 S.O. 2405-20 8" 2405
1/31 Topok 2665 Bldg 2775
1/31 Oswald 2952 6" 2953
1/31 Pay 3001-06 T 17 400' oil 2 hrs
1/31 Suck 130 Bbls 18 hrs.
2/7 6" 2965 1000 acid
2/13 Oswald 2952 Oil 3001-06
2/13 T 17 3006 1000 acid 359 Bbls.

COMPLETED

OVER

1936

O. W. D. D

10/21 - Old total depth 3006'

Oswald 2932'

Total Depth 3051'

105 bbls of oil Potential.

FIRST REPORTS

and

COMPLETED

Map No. 72 Sec. 23 Twp. 14 R. 14WWell No. 1-BurneyHartman & Blain Company

Contractor

KANSAS

SECTION PLAT

_____ Ft. from N. Line

330 Ft. from S. Line330 Ft. from E. Line

_____ Ft. from W. Line

Location ✓

Rig up _____

Drilling and Remarks:

RECORD

Cased _____ in., _____ ft.

Sand _____

Gas _____

Oil _____

Total Depth _____

PRODUCTION

1st 24 hrs. Nat. _____

1st 24 hrs. after shot _____

Gas _____ Cu. Ft.

Dry Hole _____

Abandoned _____

Date

10-31-34 19

ORVAL MANNSCHRECK Scout



[Handwritten signature]

[Handwritten signature]

Mary Pink Book

Map No. 72 Sec. 23 Twp. 14 R. 14WWell No. 1-QuirneyHartman & Blum Company

Contractor

COMPLETED**SECTION PLAT**

Ft. from N. Line

330 Ft. from S. Line330 Ft. from E. Line

Ft. from W. Line

Location

Rig up

Drilling and Remarks:

1000 acid359 lbs**RECORD**

Cased in ft.

Sand Oswald 2932

Gas

Oil 3001-06Total Depth 3006**PRODUCTION**

1st 24 hrs. Nat.

1st 24 hrs. after shot

Gas Cu. Ft.

Dry Hole

Abandoned

Date

2-13-35 192**ORVAL MANN SCHRECK**
Scout

Returned *AD*
 Cards *AD*
 Title *Miss*
 or 3 K4 0
 500 1 71 Map *X*
 Moody Flat Book

KANSAS

Map No. 72 Sec. 23 Twp. 14 R. 14WWell No. 1 Gurney "a"Hartman & Blair Company

Contractor

SECTION PLAT

_____ Ft. from N. Line

330 Ft. from S. Line330 Ft. from E. Line

_____ Ft. from W. Line

**COMPLETED
FIRST REPORT**O.W.D.D.

Location _____

O. W. D. D. RECORD

Rig up _____

Drilling and Remarks:

Oswald 2932.Old TD 3006.P & 1058 1/2

Cased _____ in., _____ ft.

Sand _____

Gas _____

Oil _____

Total Depth 3057**PRODUCTION**

1st 24 hrs. Nat. _____

1st 24 hrs. after shot _____

Gas _____ Cu. Ft.

Dry Hole _____

Abandoned _____

Date

OCT 21 1936

19

S. J. LEWIS Scout

2150/100

200/100






RAM

Returned	
Cards	RM
Tracing	OK
France Map	+
Scarborough Map	+
Moody Map	+
Scarborough Plat Book	
Moody Plat Book	