


Section 23 Township 14 Range 14W

Well No. L Gurney

Company Saco

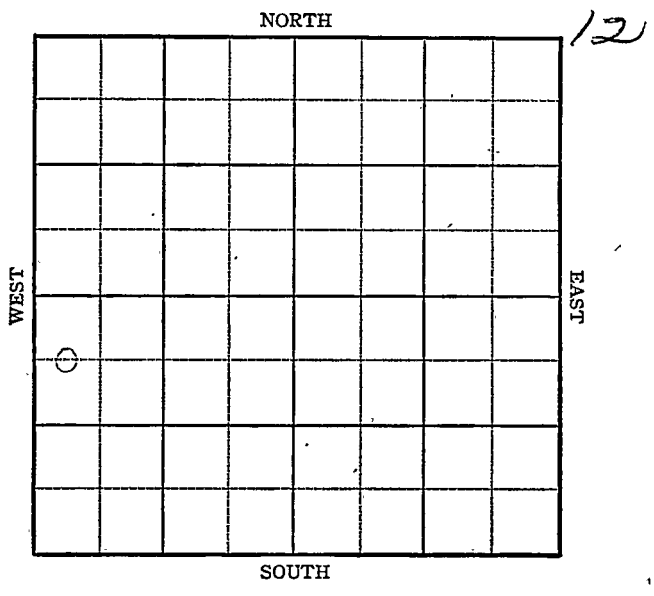

Sec. 23 Twp. 14 R. 14-W

Well No. #4 Gurney Farm _____


Saco Company _____

660 Ft. from N. Line

_____ Ft. from S. Line

_____ Ft. from E. Line

330 Ft. from W. Line

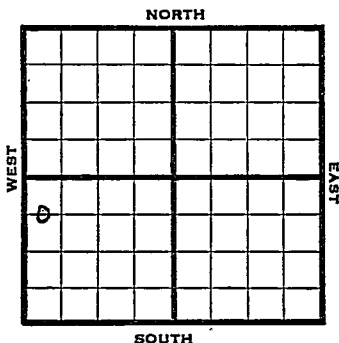

C W L NW SW

1945

Elev. 1819

REPORT

9/26 Surface hole

10/3

8" @ 583
Anhy. 815
Topeka 2670
Drig. 2698

10/10

Lans 2965-2966
TD 2966 SO
5" @ 2962 RUST

10/17

TD 3008' SSO

10/24

Lans 2965
5" @ 2962
5000 acid.
TD 3008'
Pump 233 Pot.
Grav. 39.7

COMPLETED

KANSAS
KansasPool Name Hal 1-GurneyMap No. 72 Sec. 23 Twp. 14 R. 14WWell No. 4 Gurney

Saco

Company

FIRST REPORT

Contractor

C W L NW SW

660 Ft. from N. Line Ft. from S. Line Ft. from E. Line330 Ft. from W. Line

SECTION PLAT

0			

Russell County

Location 9/24Rig up Drilling and Remarks:
surface hole

RECORD

Cased in., ft.Sand Gas Oil Total Depth

PRODUCTION

1st 24 hrs. Nat. 1st 24 hrs. after shot Gas Cu. Ft.Dry Hole Abandoned

Date

SEP 26 194519S. J. LEWIS

Scout

KANSAS

Kansas

Pool Name Hall-GurneyMap No. 72 Sec. 23 Twp. 14 R. 14WWell No. 4 Gurney

Saco

Company

COMPLETED

Contractor

C W L NW SW

E. 1879
SECTION PLAT660 Ft. from N. Line

_____ Ft. from S. Line

_____ Ft. from E. Line

330 Ft. from W. Line

Russell County

Location _____

Rig up _____

Drilling and Remarks:

*Lane 2965**5' @ 2962**5000 acid**Prog 233 Pst**392 hr*

RECORD

Cased _____ in., _____ ft.

Sand _____

Gas _____

Oil _____

Total Depth 3005

PRODUCTION

1st 24 hrs. Nat. _____

1st 24 hrs. after shot _____

Gas _____ Cu. Ft.

Dry Hole _____

Abandoned _____

Date

OCT 24 1945 19S. J. LEWIS Scout