

KANSAS


Russell County

FORM 51 5M 1-42 PETROL

Section 23 Township 14 Range 14W

Well No. 6 Gurney

Company Harry Gore

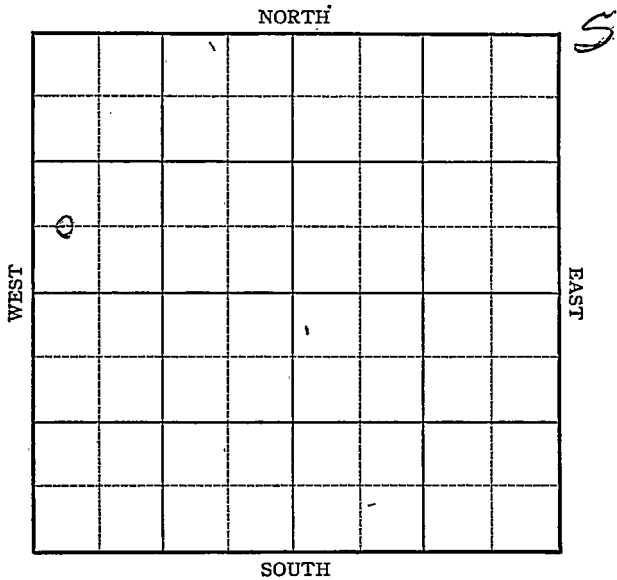

KANSAS

Russell

Sec. 23 Twp. 14 R. 14W

Well No. #6 Gurney Farm
Harry Gore Company


Hall-Gurney

 Ft. from N. Line

660' Ft. from S. Line

 Ft. from E. Line

330' Ft. from W. Line

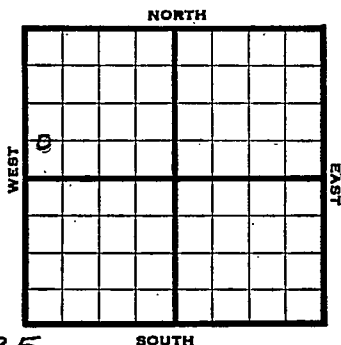

Elev. 1835

1944

REPORT

6/27 Rigging up cable
Have bought this lease for
Hartman & Blair

7/12 15" @ 29' Drlg 355
7/19 12" @ 488 10" @ 842
Drilling 925

7/26 Drlg. 1940'

8/2 Drlg. 2115'

8/9 8" @ 2095 - 2115 NR 8"

8/16 2157 fsg.

8/23 2489 NR 8"

8/30 Drlg. 2500

9/8 TD 2550 SD

9/13 6" @ 2484 2685 SD

9/21 Topeka 2685 - 2825 fsg.

9/28 Lans 2975 SO 3003-16

TD 3011 5½" @ 3005 RUST

10/4 TD 3071 4000 acid

10/11 Lans 2975'

5" @ 3005

TD 3071'

4000 acid.

Pump 280 Pot.

40.7 gravity

COMPLETED

KANSAS

Pool Name Hall-Gurney

Map No. 72 Sec. 23 Twp. 14 R. 14W

Well No. 6 Gurney

Harry Gore Company

FIRST REPORT Contractor

C W L SW NW

SECTION PLAT

 Ft. from N. Line

660 Ft. from S. Line

 Ft. from E. Line

330 Ft. from W. Line

o			

Russell County

Location

Rig up

Drilling and Remarks:
Rigging up cable
Have bought this
lease for
Hartman & Blair

RECORD

Cased in., ft.

Sand

Gas

Oil

Total Depth

PRODUCTION

1st 24 hrs. Nat.

1st 24 hrs. after shot

Gas Cu. Ft.

Dry Hole

Abandoned

Date

JUN 2 8 1944 19

S. J. LEWIS Scout

Pool Name Hall - Gurney P

Map No. 72 Sec. 23 Twp. 14 R. 14 W

Well No. 6 Gurney

Harry Gore Company

COMPLETED Contractor

C W L SW NW

SECTION PLAT

0			

 Ft. from N. Line

660 Ft. from S. Line

 Ft. from E. Line

330 Ft. from W. Line

Russell County

Location

Rig up

Drilling and Remarks:

Loss 2975

5-203005

4000 Acid

Pump 280 P.Y.

402 Gr

RECORD

Cased in., ft.

Sand

Gas

Oil

Total Depth 3071

PRODUCTION

1st 24 hrs. Nat.

1st 24 hrs. after shot

Gas Cu. Ft.

Dry Hole

Abandoned

Date

OCT 11 1944 19

S. J. LEWIS Scout