FORM 51 25M 3-49 PETROL KANSAS

Russell


Section 23 Township 14 Range 14W

Well No. 7 Gurney

Company Texas

Hall-Gurney

2

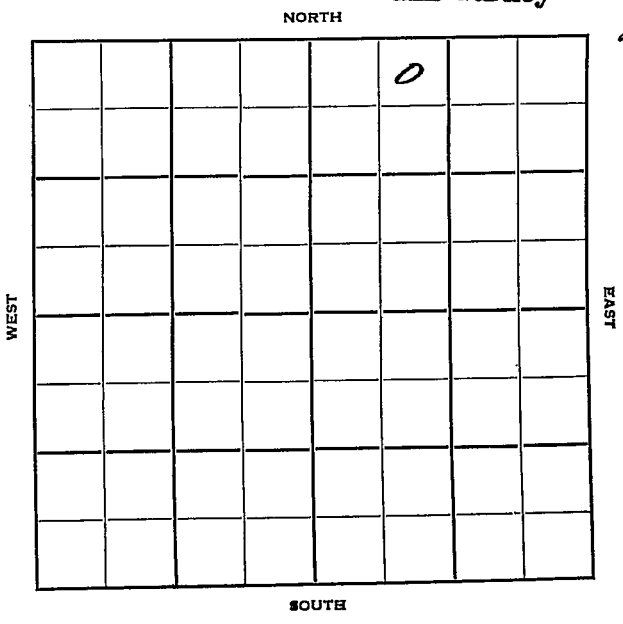

FORM 252-A
5M 10-48 PETROL

Russell KANSAS

Sec. 23 Twp. 14 R. 14W

Well No. #7 Gurney Farm

Texas Company

Hall-Gurney Pool


330' Ft. from N. Line

Ft. from S. Line

Ft. from E. Line

990' Ft. from W. Line

NE NW NE

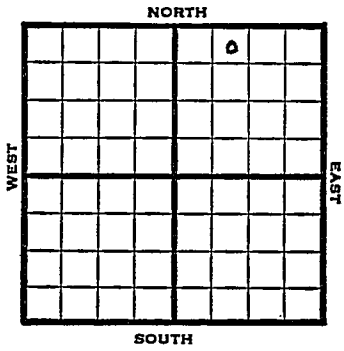

1949	Elev. 1810' REPORT
7/20	10"@ 795'
7/27	Tarkio 2335'
	TD 2340'
	7"@ 2337'
8/3	TD 2365'
	500 acid
	CO
8/10	49' of 5" Perf Liner @ 2378'
	TD 2380'
	Swb 8 bbls oil 12 hrs.
8/17	"
8/24	TD 2380'
8/31	"
9/7	Tarkio 2335'
	7" @ 2337'
	Pump 5 oil Pot.
	Grav. 40.9
	TD 2380'
	COMPLETED

Form 26 200 Bks. 6-49 Petrol

Kansas

Hall-Gurney Pool

Map No. Sec. 23 Twp. 14 R. 14W

Well No. 7 Gurney


Texas Company

Contractor

NE NW NE

FIRST REPORT

SECTION PLAT

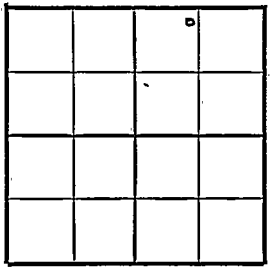

330 Ft. from N. Line

Ft. from S. Line

Ft. from E. Line

990 Ft. from W. Line

Russell County

Location

Rig up

Drilling and Remarks:

10" at 795

RECORD

Cased in., ft.

Sand

Gas

Oil

Total Depth

PRODUCTION

1st 24 hrs. Nat.

1st 24 hrs. after shot

Gas Cu. Ft.

Dry Hole

Abandoned

Date

JUL 20 1949 19

S. J. LEWIS Scout

Form 26 200 Bks. 6-49 Petrol

Hall-Gurney Pool

Kansas

Map No. K-72 Sec. 23 Twp. 14 R. 14W

Well No. 7 Gurney


Texas Company

COMPLETE Contractor

NE NW NE

Elev. 1870

SECTION PLAT

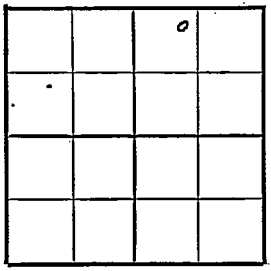

330 Ft. from N. Line

____ Ft. from S. Line

____ Ft. from E. Line

990 Ft. from W. Line

Russell County

Location

Rig up

Drilling and Remarks:

Markir 2335

7" @ 2337

Pump Soil Pet

40 ? Gr

RECORD

Cased 7" in., ____ ft.

Sand

Gas

Oil

Total Depth 2338

PRODUCTION

1st 24 hrs. Nat.

1st 24 hrs. after shot

Gas Cu. Ft.

Dry Hole

Abandoned

Date

SEP 7 1949 19

S. J. LEWIS Scout