

KANSAS


Russell

FORM 51 5M PETROL

Section 23 Township 14 Range 14-W

Well No. # 5 Gurney

Company Texas

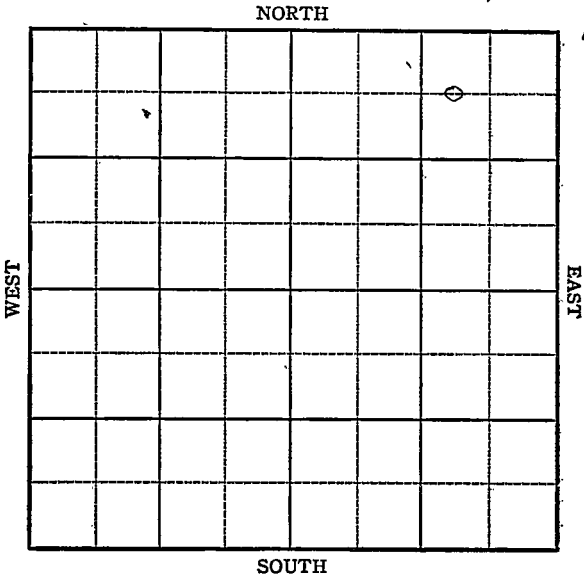

Sec. 23 Twp. 14 R. 14 W

Well No. #5 Gurney Farm \_\_\_\_\_  
 \_\_\_\_\_ Texas \_\_\_\_\_ Company


660 Ft. from N. Line

\_\_\_\_\_ Ft. from S. Line

990 Ft. from E. Line

\_\_\_\_\_ Ft. from W. Line

*Elev. 1812*

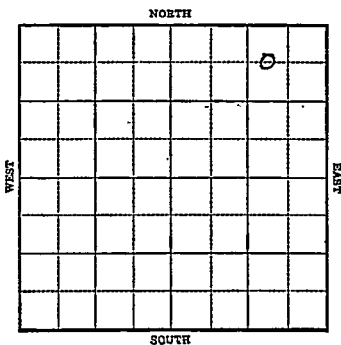

1943

R E P O R T

<p>12-8 12-15  12/22  12/29 1944 1-5  1-12  1/19</p>	<p>Location Rotary  10" @ 367 WOC. 1925 fsg  Lans 2974-82 TD 7" @ 2974 RUST  3030 TD 500 acid.  7" @ 2974 Lans 2974 TD 3050 4000 acid Pump 545 oil &amp; 65% water <sup>P</sup>to. Gravity 38</p>
--	---

**COMPLETED**

Map No. 72 Sec. 23 Twp. 14 R. 14 W

Well No. 5 Gurney

Texas Company

FIRST REPORT

Contractor

C W L NE NE

SECTION PLAT

660 Ft. from N. Line

\_\_\_\_\_ Ft. from S. Line

990 Ft. from E. Line

\_\_\_\_\_ Ft. from W. Line

			c

Hall-Gurney Pool

Location X

Rig up \_\_\_\_\_

Drilling and Remarks:

RECORD

Cased \_\_\_\_\_ in., \_\_\_\_\_ ft.

Sand \_\_\_\_\_

Gas \_\_\_\_\_

Oil \_\_\_\_\_

Total Depth \_\_\_\_\_

PRODUCTION

1st 24 hrs. Nat. \_\_\_\_\_

1st 24 hrs. after shot \_\_\_\_\_

Gas \_\_\_\_\_ Cu. Ft.

Dry Hole \_\_\_\_\_

Abandoned \_\_\_\_\_

Date

DEC 8 1943 19

S. J. LEWIS Scout

LWSAS

Map No. 7 Sec. 23 Twp. 14 R. 14W

Well No. 5 Gurney

Texas Company

COMPLETED

Contractor

C W L N E N E

SECTION PLAT

660 Ft. from N. Line

\_\_\_\_\_ Ft. from S. Line

990 Ft. from E. Line

\_\_\_\_\_ Ft. from W. Line

			o

Hall-Gurney Pool

Location \_\_\_\_\_

Rig up \_\_\_\_\_

Drilling and Remarks:

*Loc 2974*

*7" @ 2974*

*4000 cask*

*Pump 545 oil +  
65% water PT*

*38° S*

RECORD

Cased \_\_\_\_\_ in., \_\_\_\_\_ ft.

Sand \_\_\_\_\_

Gas \_\_\_\_\_

Oil \_\_\_\_\_

Total Depth 3050

PRODUCTION

1st 24 hrs. Nat. \_\_\_\_\_

1st 24 hrs. after shot \_\_\_\_\_

Gas \_\_\_\_\_ Cu. Ft.

Dry Hole \_\_\_\_\_

Abandoned \_\_\_\_\_

Date

JAN 19 1944 19

S. J. LEWIS Scout