

Russell


Map No. **KANSAS** Sec. 23 Twp. 14 R. 14^W

Well No. 2 in Murray Farm _____
Super Company _____

NORTH

WEST

EAST

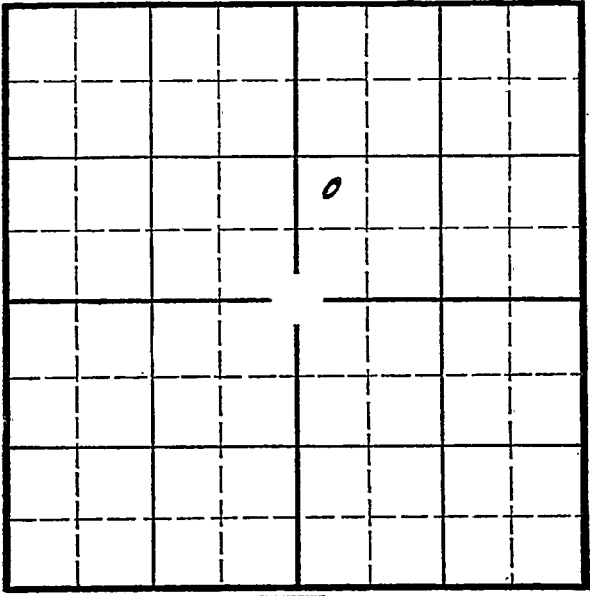

SOUTH

Location _____

Drilling Remarks _____

Rig Up _____

Drilling Remarks _____

RECORD

Cased _____ in. _____ ft.
 Sand _____
 Gas _____
 Oil _____
 Total Depth _____

PRODUCTION

1st 24 hrs. Nat. _____
 1st 24 hrs. after shot _____
 Gas _____ cu. ft. _____
 Dry Hole _____
 Abandoned _____

Russell

Map No. KANSAS Sec. 23 Twp. 14 R. 14W

Well No. 2 - Murrey Farm _____
Lynn Company _____


_____ Ft. from N. Line

990 Ft. from S. Line

_____ Ft. from E. Line

330 Ft. from W. Line

Elev. 1804

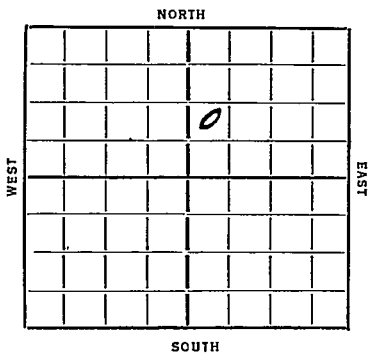

Date	REPORT
1/15	Location
1/24	Cellar
1/31	Rgn
2/7	Spud o SD.
2/14	15" 310 12" 472
	Aug 777 10" 788
	Drlg 1940
2/21	" 2190
2/28	SO 2355-58 8" 2389
	SO 2480-90 40 2720
	Drlg 2835
3/6	Drlg 2835
3/13	--
	<i>over</i>
3/20	T. Oswego. 2951 6"-2955 Show oil and gas 3135 DrLg. 3145
3/27	T.D. 3241 Plugged back to 3140' acidizing.
4/2	1000 acid.
4/8	Overd 3135-45 TD 3241 TD 3241 PB 3153
	1000 acid
	240 Oil 5 water.

COMPLETED

Map No. 72 Sec. 23 Twp. 14 R. 14

Well No. 2-Gurney

Texas Company

Contractor

FIRST REPORTS

..... Ft. from N. Line

990 Ft. from S. Line

..... Ft. from E. Line

330 Ft. from W. Line

SECTION PLAT

		0	

Location

Rig up

Drilling and Remarks:

RECORD

Cased..... in., ft.

Sand.....

Gas.....

Oil.....

Total Depth.....

PRODUCTION

1st 24 hrs. Nat.....

1st 24 hrs. after shot.....

Gas..... Cu. Ft.

Dry Hole.....

Abandoned.....

Date

1-15-36 192

ORVAL MANNSCHRECK

Scout

no more

[Handwritten flourish]

[Handwritten flourish]

Returned	<i>AB</i>
Cards	<i>AB</i>
Tracing	<i>AB</i>
France Map	<i>✓</i>
Scarborough Map	<i>X</i>
Moody Map	<i>✓</i>
Scarborough Pic Book	
Moody Plat Book	

Russell
Map No. 72 Sec. 22 Twp. 14 R. 14W

Well No. 2 Gurney

Texas Oil Company

Contractor

SECTION PLAT

..... Ft. from N. Line

990 Ft. from S. Line

..... Ft. from E. Line

320 Ft. from W. Line

		0	.

COMPLETED

Location.....

Rig up.....

Drilling and Remarks:

Crowald 3135-40

P.B. 8153

1000 acid

240 oil & 5 water

RECORD

Cased..... in., ft.

Sand.....

Gas.....

Oil.....

Total Depth 3241

PRODUCTION

1st 24 hrs. Nat.....

1st 24 hrs. after shot.....

Gas..... Cu. Ft.

Dry Hole.....

Abandoned.....

Date

4/1/36 192.....

S. J. LEWIS

Scout

Annual map

Returned	<input checked="" type="checkbox"/>
Cards	<input checked="" type="checkbox"/>
Tracing	<input checked="" type="checkbox"/>
France Map	<input checked="" type="checkbox"/>
Scarborough Map	<input checked="" type="checkbox"/>
Moody Map	<input checked="" type="checkbox"/>
Scarborough Plot Book	<input type="checkbox"/>
Moody Plot Book	<input type="checkbox"/>