

Sec. 23 Twp. 14 R. 14-WWell No. #4 Gurney "A" FarmHartman & Blair Company

(Gurney)


660 Ft. from N. Line

_____ Ft. from S. Line

_____ Ft. from E. Line

990 Ft. from W. Line

Elev. 1828

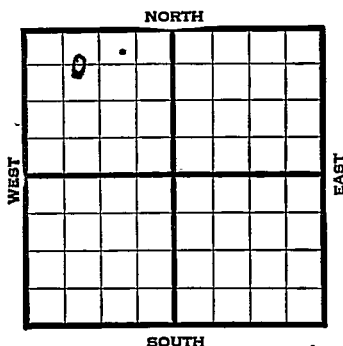

1940	REPORT
5/8	Cable rig.
5/16	Rigging up.
5/23	20" - 41' 15" - 315'
	12" - 502' Drlg. 635'
5/29	Anhy 800' 10" - 813'
	Drlg. 1575'
6/6	Show gas 1705-10' Drlg. 2240'
6/13	S.S.O. 2370-75' 8" - 2390'
	Drlg. 2740'
6/20	Dodge 2927' Lans. 2982'
	Oil 2998-3003' & 3003-10' T.D.
	7" - 2983' WOC.
6/27	T.D. 3014' 6000 acid.
	Pump 10 bbls. per hour.
7/2	Lans. 2982'
	7" - 2983'
	T.D. 3014'
	6000 acid.
	Potential 15 bbls.
	COMPLETED

Map No. 72 Sec. 23 Twp. 14 R. 14WWell No. 4 Gurney "A"Hartman & Blair CompanyFIRST REPORT Contractor

C E L NW NW

660 Ft. from N. Line

_____ Ft. from S. Line

_____ Ft. from E. Line

990 Ft. from W. Line

GURNEY POOL

SECTION PLAT

o			

Location _____

Rig up _____

Drilling and Remarks:

Cable Rig

RECORD

Cased _____ in., _____ ft.

Sand _____

Gas _____

Oil _____

Total Depth _____

PRODUCTION

1st 24 hrs. Nat. _____

1st 24 hrs. after shot _____

Gas _____ Cu. Ft.

Dry Hole _____

Abandoned _____

Date

MAY 8 1940 19S. J. LEWIS

Scout

Map No. 72 Sec. 23 Twp. 14 R. 14WWell No. 4 Gurney "A"Hartman & Blair

Company

Contractor

COMPLETED

C E L NW NW

660 Ft. from N. Line

_____ Ft. from S. Line

_____ Ft. from E. Line

990 Ft. from W. Line

GURNEY POOL

SECTION PLAT

o			

Location _____

Rig up _____

Drilling and Remarks:

*Loss 2982**7" @ 2983**6000 acid**158 H.P.Y.***RECORD**

Cased _____ in., _____ ft.

Sand _____

Gas _____

Oil _____

Total Depth 3014**PRODUCTION**

1st 24 hrs. Nat. _____

1st 24 hrs. after shot _____

Gas _____ Cu. Ft.

Dry Hole _____

Abandoned _____

Date

JUL 2 1940

19

S. J. LEWIS Scout