


Section 23 Township 14 Range 14-W

Well No. 2 Gurney

Company Hartman & Blair

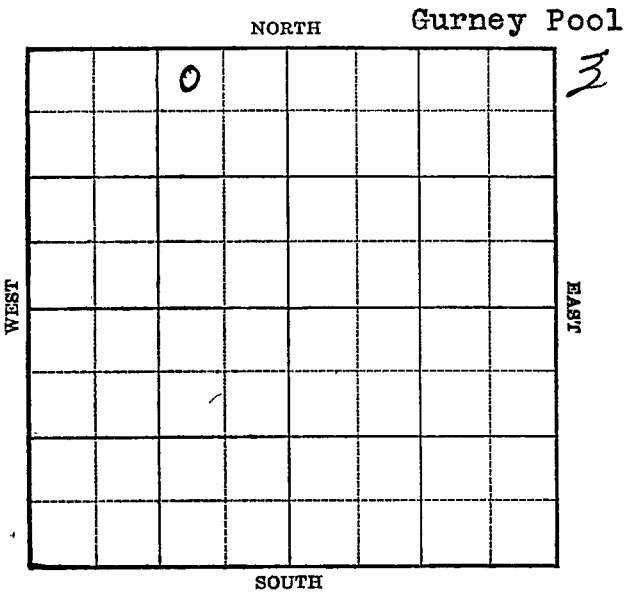

Sec. 23 Twp. 14 R. 14-W

Well No. #2 Gurney Farm

Hartman & Blair Company


(Gurney)

330 Ft. from N. Line

\_\_\_\_\_ Ft. from S. Line

990 Ft. from E. Line

\_\_\_\_\_ Ft. from W. Line

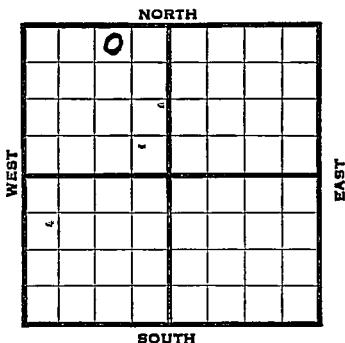

1939	REPORT
3/15	RUCT.
3/24	15" - 320' Drlg. 395'
3/31	12" - 492' Anhy 793' 10" - 805' Drlg. 1630'
4/7	S. G. 1705-10' T.D. 2285' Rng. 8".
4/14	8" - 2294' S.O. & G. 2373-85' Toneka 2665' Drlg. 2855'
4/21	Lans. 2958' 7" - 2968' S. O. 3033-38' T.D. 3046' 2 oil per hour.
4/28	14,000 acid. Drlg. 3155'
5/5	Pump 578 bbls. oil from Lans. On pot. Drilled to Granite wash 3220' T.D. 3302' P. B. to Lans.
5/12	" " "
OVER	

1939

5/17

Lans. 2958'

7" = 2968'

Granite wash 3220'

T.D. 3302'

P. B. to 3126'

14,000 acid.

2000 acid.

Potential 518 bbls.

**COMPLETED**

Map No. 72 Sec. 23 Twp. 14 R. 14WWell No. 2 GurneyHartman & Blair

Company

Contractor

## FIRST REPORT

## SECTION PLAT

330 NW NE NW  
Ft. from N. Line

Ft. from S. Line

990 Ft. from E. Line

Ft. from W. Line

	0		

## GURNEY POOL

Location \_\_\_\_\_

Rig up \_\_\_\_\_

Drilling and Remarks:

RUCT

## RECORD

Cased \_\_\_\_\_ in., \_\_\_\_\_ ft.

Sand \_\_\_\_\_

Gas \_\_\_\_\_

Oil \_\_\_\_\_

Total Depth \_\_\_\_\_

## PRODUCTION

1st 24 hrs. Nat. \_\_\_\_\_

1st 24 hrs. after shot \_\_\_\_\_

Gas \_\_\_\_\_ Cu. Ft.

Dry Hole \_\_\_\_\_

Abandoned \_\_\_\_\_

Date

MAR 15 1939

19

E. D. Hatfield

Scout

Misc. Small Maps  
Cards  
Tracing  
France Map  
Scarborough Map  
Moody Map  
Geological Dept.  
Moody Flat Book

*Handwritten signatures and initials, including 'BOY' and 'G.M.'.*

Map No. 72 Sec. 23 Twp. 14 R. 14WWell No. 2 GurneyHartman & Blair

Company

Contractor

COMPLETED

NW NE NW

330 Ft. from N. Line

\_\_\_\_\_ Ft. from S. Line

990 Ft. from E. Line

\_\_\_\_\_ Ft. from W. Line

## SECTION PLAT

	o		

GURNEY POOL

Location \_\_\_\_\_

Rig up \_\_\_\_\_

Drilling and Remarks:

*Lans. 2958*  
*7" @ 2968*  
*Granite Wash 3020*  
*P. B 3126*  
*14000 acid*  
*2000 acid*  
*P 8 518*

## RECORD

Cased \_\_\_\_\_ in., \_\_\_\_\_ ft.

Sand \_\_\_\_\_

Gas \_\_\_\_\_

Oil \_\_\_\_\_

Total Depth 3302

## PRODUCTION

1st 24 hrs. Nat. \_\_\_\_\_

1st 24 hrs. after shot \_\_\_\_\_

Gas \_\_\_\_\_ Cu. Ft.

Dry Hole \_\_\_\_\_

Abandoned \_\_\_\_\_

Date

MAY 17 1939 19

S. J. LEWIS

Scout

Misc Small Maps  
Cards.....  
Tracing.....  
France Map.....  
Scarborough Map.....  
Moody Map.....  
Geological Dept. ....  
Moody Plat Book .....

*RAY*  
*RAY*  
*J.R.*  
*RAY*  
*L*