


KANSAS

Russell

FORM 51 25M 3-49 PETROL

Section 23 Township 14 Range 15-WWell No. #3 FurthmeyerCompany Herbel (was Texas)

NORTH

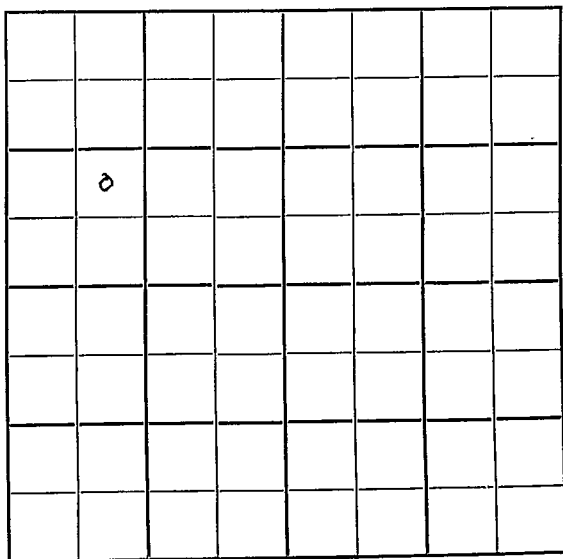

SOUTH

Russell KANSAS

Sec. 23 Twp. 14 R. 15W ✓

Well No. #3 Futhmeyer Farm

Herbe (was Texas) Company

Brunson Drlg. - Cont. Contractor
Big Creek Pool


 Ft. from N. Line

990' Ft. from S. Line

 Ft. from E. Line

990' Ft. from W. Line

NE SW NW

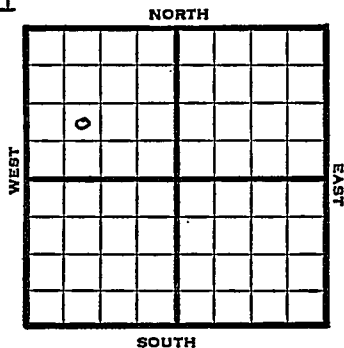


1950 Elev. 1757' REPORT

10/4 Spud 9-30-50
8-5/8" @ 820'

11/8 Spud 9-30-50
Oil Well TD 3168'
8-5/8" @ 820
Anhy 832'
Heeb. 2877'
Arb. 3164'
5" @ 3165' TD 3168'
Comp. 60 BOPD

COMPLETED

County Russell State Kansas
 Sec. 23 (Blk. 14 (Sur. 15W Map No.
 (Twp.) (Rge.)
 Operator Herbel (was Texas)
 Well No. 3 Farm Furthmeyer
 Elev. 1757 Location NE SW NW

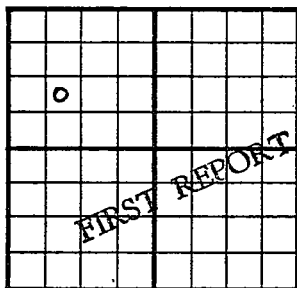

990 Ft. From S Line NW

990 Ft. From W Line Quarter

Ist. Report OCT 4 1950

Completion

Remarks

Brunson Drlg. - Contr.

Spudding Date 9-30-50

Drlg. Data

Big Creek Pool

8 5/8" @ 820



Sec.	23	(Blk.) (Twp.)	14	(Sur.) (Rge.)	15W	Map No.
------	----	------------------	----	------------------	-----	---------

Well No. 3 Farm Furthmeyer

0

COMPLETE

990 Ft. From W Line Quarter

1st. Report

Completion NOV 8 '50

Remarks Big Creek Pool

Brunson Drlg. - Contr.

Spudding Date 9-30-50

Drig. Data Oil well TD 3168

8-15/8" @ 820 Anhy 832 Heeb. 2877

Arb. 3164 5" @ 3165 TD 3168

Comp. 60 bond

J. E. TYRA