


Section 23 Township 14 Range 15WWell No. #1 FurthmeyerCompany Murfin Drlg.

NORTH

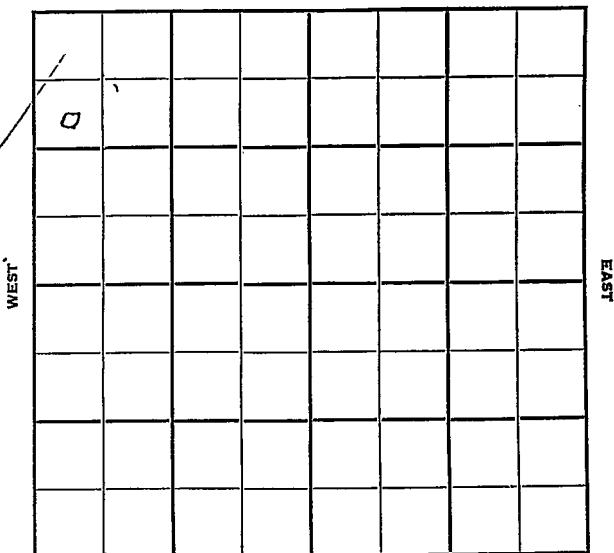

SOUTH

Russell

KANSAS

Sec. 23 Twp. 14 R. 15 W

Well No. # 4 Furthmeyer Farm

Murfin Drlg. Company

Contractor


990 Ft. from N. Line

Ft. from S. Line

Ft. from E. Line

330 Ft. from W. Line

SW NW NW

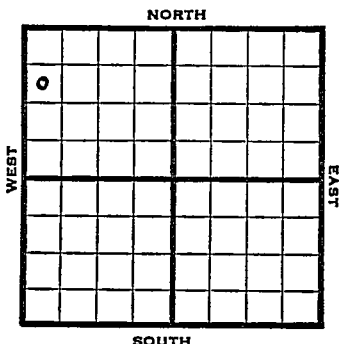

1952

Elev. 1797' REPORT

1/30

Drlg. 2630'

2/6

5" @ 3210' TD 3210'

2/13

DD 3212 Fill up 900' oil

2/20

500 A Fill up 2600' oil
S/5 BOPH for 4 hrs. POP

2/27

Oil Well TD 3212
8" @ 845

Lans. 2972 Arb. 3209

TD 3210 5" @ 3210 DD 3212

FU 900' oil 500 A FU 2600' oil

S/ 5 boph 4 hr. Comp. 50 bopd

COMPLETED

County Russell State Kansas
 Sec. 23 (Blk. 14) (Sur. 15W) Map No.

Operator Marfin Drig.

Well No. 4 Farm Burthmeyer

Elev. 1797 Location SW NW NW

FIRST REPORT

990 Ft. From N Line NW

330 Ft. From W Line Quarter

1st. Report JAN 30 1952

Completion

Remarks

Spudding Date

Drig. Data

Drig. 2630


J. G. McGEHEE

County Russell State Kansas
 Sec. 23 (Blk.) 14 (Sur.) 15W Map No.

Operator Murfin Drlg.

Well No. 4 Farm Furthmeyer

Elev. 1797 Location SW NW NW

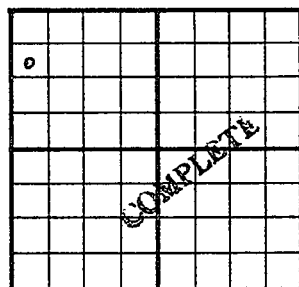

990 Ft. From N Line NW

330 Ft. From W Line Quarter

1st. Report

Completion FEB 27 1952

Remarks

Spudding Date

Drlg. Data Oil well TD 3212

8" @ 845 Lans. 2972 Arb. 3209

TD 3210 5" @ 3210 DD 3212

FU 900' oil 500 A FU 2600' oil

S/ 5 boph 4 hr. Comp. 50 bopd

J. G. McGEHEE