

KANSAS

FORM 51 5M 4-41 PETROL

Russell

Section 23 Township 14 Range 15-W

Well No. #4 Neidenthal

Company Palmer


Big Creek Pool

NORTH

WEST

EAST

SOUTH

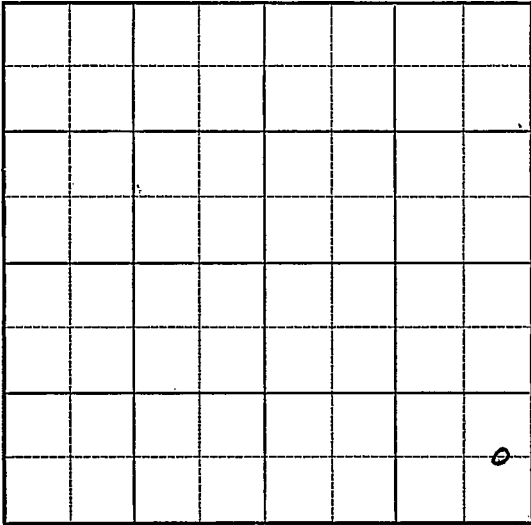

Map No. 72 Sec. 23 Twp. 14 R. 15WWell No. 4 NeidenthalPalmer

Company

Contractor

FIRST REPORT

C E L S E S E

 Ft. from N. Line660 Ft. from S. Line330 Ft. from E. Line Ft. from W. Line

SECTION PLAT

BIG CREEK POOL

Location Rig up

Drilling and Remarks:

Cellar

RECORD

Cased in., ft.Sand Gas Oil Total Depth

PRODUCTION

1st 24 hrs. Nat. 1st 24 hrs. after shot Gas Cu. Ft.Dry Hole Abandoned

Date

MAY 7 1941 19

S. J. LEWIS

Scout

Map No. _____ Sec. 23 Twp. 14 R. 15WWell No. 4 NeidenthalPalmer

Company _____

ABANDONED

Contractor _____

C E L S E S E

SECTION PLAT

_____ Ft. from N. Line

660 Ft. from S. Line330 Ft. from E. Line

_____ Ft. from W. Line

BIG CREEK POOL

Location ✓

Rig up _____

Drilling and Remarks:

RECORD

Cased _____ in., _____ ft.

Sand _____

Gas _____

Oil _____

Total Depth _____

PRODUCTION

1st 24 hrs. Nat. _____

1st 24 hrs. after shot _____

Gas _____ Cu. Ft.

Dry Hole _____

Abandoned _____

Date

AUG 6 1941 19S. J. LEWIS Scout