
Russell

Form 51—5M—5-34—Palace

Map No. KANSAS Sec. 23 Twp. 14 R. 14W

Well No. 1 Gurney Farm

Skelly Oil Company

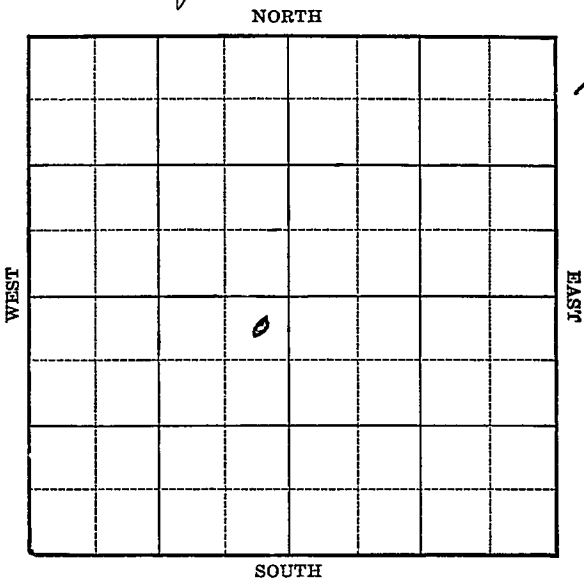

Location	Rig Up
Drilling Remarks	Drilling Remarks

RECORD

Cased ____ in. ____ ft.

Sand

Gas

Oil

Total Depth

PRODUCTION

1st 24 hrs. Nat.

1st 24 hrs. after shot

Gas ____ cu. ft.

Dry Hole

Abandoned

Form 252-A
5M 7-34 MPC

Russell

Map No. KANSAS Sec. 23 Twp. 14 R. 14W

Well No. 1 Gurney Farm


Skelly Oil Company

330 Ft. from N. Line

____ Ft. from S. Line

330 Ft. from E. Line

____ Ft. from W. Line

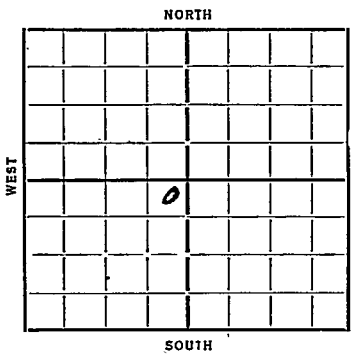

Date 1935	REPORT
3/13	Moving in
3/21	Rig
3/28	
4/4	Dlg 350 15½ 349
4/11	" 650 12" 487
4/18	" 1360
4/26	" 2175
5/2	" 2740
5/9	8" 2424 Sand 2360-64
	SS 2535
5/16	Dlg 2665 Sd 2565
5/23	2685 WR 8"
5/29	Dlg 2695 8" 2670
6/6	Lansing 2962 6" 2983
	S.O. 2998 TD 3000
	100% oil 12 hrs
6/12	Lansing 2962 TD 3009
	1000 Mcf 442 oil
	6 Water
	COMPLETED

KANSAS

Form 26—1M Blue 9-28

Russell

Map No. 72 Sec. 23 Twp. 14 R. 14W

Well No. 1 - Burney

Skelly Oil Company

Contractor

FIRST REPORTS


330 Ft. from N. Line

Ft. from S. Line

330 Ft. from E. Line

Ft. from W. Line

SECTION PLAT

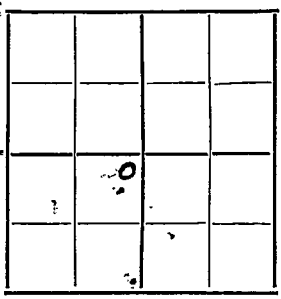

Location

Rig up

Drilling and Remarks:

Moving in

RECORD

Cased in., ft.

Sand

Gas

Oil

Total Depth

PRODUCTION

1st 24 hrs. Nat.

1st 24 hrs. after shot

Gas Cu. Ft.

Dry Hole

Abandoned

Date

3-13-35 192

ORVAL MANNSCHRECK Scout

Form 26—1M Bks. 9-28

Russell

Map No. 72 Sec. 23 Twp. 14 R. 14W

Well No. 1 Burney

Skelly Oil Company

Contractor

COMPLETED


SECTION PLAT

330 Ft. from N. Line

Ft. from S. Line

330 Ft. from E. Line

Ft. from W. Line

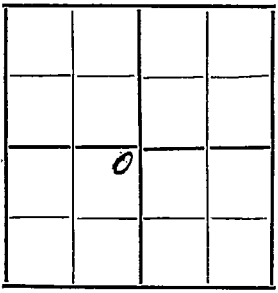

Location

Rig up

Drilling and Remarks:
1000 and
442 ft shot
6 water

RECORD

Cased in., ft.

~~Sand~~ Lansing 2962

Gas

Oil

Total Depth 3009

PRODUCTION

1st 24 hrs. Nat.

1st 24 hrs. after shot

Gas Cu. Ft.

Dry Hole

Abandoned

Date

6-12-35 192

ORVAL MANTSCHRECK Scout