

Russell

Map No. KANSAS Sec. 23 Twp. 14 R. 14^W


Well No. 1- Gurney Farm
Hypox oil Co. Company

330 Ft. from N. Line

_____ Ft. from S. Line

_____ Ft. from E. Line

330 Ft. from W. Line

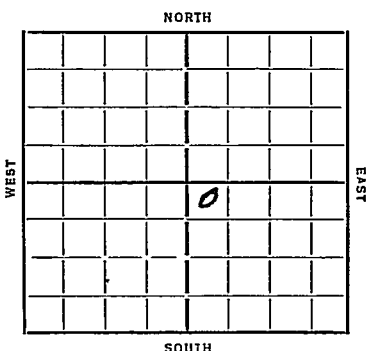

DATE	REPORT
5/15	Bldg Rig
5/23	Road
5/29	Spud
6/6	Dly 345 10" 786
6/13	" 1550 Aug 775
6/20	Dly 2230
6/28	" 2525 8" 2400
7/3	so 2525-33 T7 2665
	Topeka 2652
7/14	Dly 2677 8" 2659
7/18	Shall 2926
	so 2980-86 T7 2991 Run 6"
8/7	Granite wash
	3195 T. D. 3230
	1000 acid
	6 oil
	94 water
	10. + a. 3230
	ABANDONED

Map No. 72 Sec. 23 Twp. 14 R. 14^N

Well No. 1 - Gurney

Gypsy Oil Company

Contractor

FIRST REPORTS SECTION PLAT

330 Ft. from N. Line

..... Ft. from S. Line

..... Ft. from E. Line

330 Ft. from W. Line

		0	

Location.....

Rig up.....

Drilling and Remarks:

Beag Rig

RECORD

Cased..... in., ft.

Sand.....

Gas.....

Oil.....

Total Depth.....

PRODUCTION

1st 24 hrs. Nat.....

1st 24 hrs. after shot.....

Gas..... Cu. Ft.

Dry Hole.....

Abandoned.....

Date

5-15-35 192.....

ORVAL MANSCHRECK

Scout

Map No. 72 Sec. 23 Twp. 14 R. 14W

Well No. 1 - Gurney

Gypsy Oil Company

Contractor

ABANDONED

SECTION PLAT

330 Ft. from N. Line

..... Ft. from S. Line

..... Ft. from E. Line

330 Ft. from W. Line

		0	

Location.....

Rig up.....

Drilling and Remarks: .

1000 and

6 oil
94 water

10 + A

RECORD

Cased _____ in. _____ ft.
 Sand Granite Wash
3195
 Oil.....
 Total Depth 3230

PRODUCTION

1st 24 hrs. Nat.....
 1st 24 hrs. after shot.....
 Gas..... Cu. Ft.
 Dry Hole.....
 Abandoned.....

Date

8-7-35

192

WANSCHRECK

Scout