
FORM 51 10M 8-47 KANSAS Russell

Section 23 Township 14 Range 14W

Well No. #1 Gurney

Company Musgrove et al

Hall-Gurney

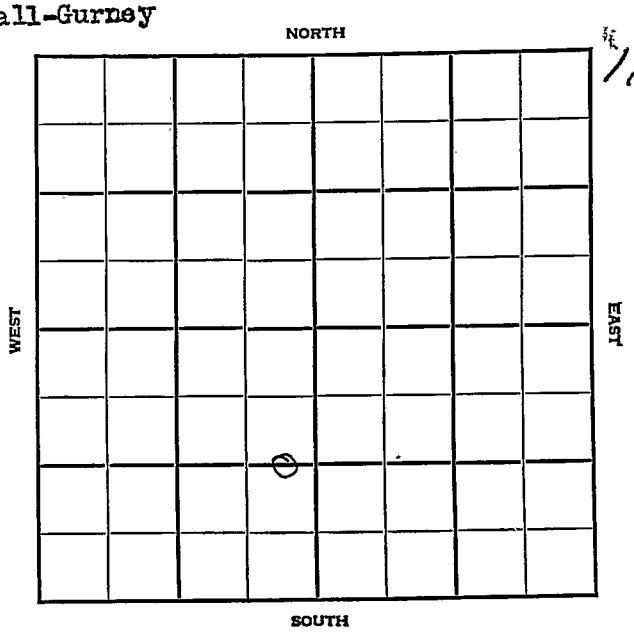

FORM 252-A
5M 9-47 PETROL KANSAS Russell ✓

Sec. 23 Twp. 14 R. 14W

Well No. #1 Gurney Farm

Musgrove et al Company

Hall-Gurney


1320' Ft. from N. Line

Ft. from S. Line

330' Ft. from E. Line

Ft. from W. Line

C E L SW

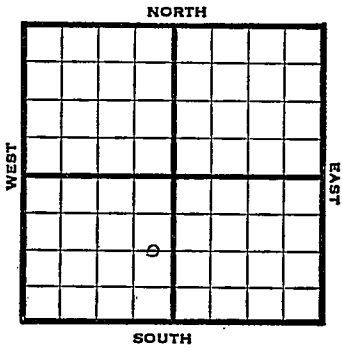


| 1948 | Elev. 1822' REPORT |
|---|---|
| 2/11 | Surface Hole |
| 2/18 | 8"@ 162'<br>Drlg 1845' |
| 2/25 | Lansing 2959'<br>TD 3035'<br>5" @ 3035'<br>RUST |
| 3/3 | " |
| 3/10 | TD 3040' SD |
| 3/17 | TD 3074'<br>4500 acid.<br>Swab 8 bbls. oil PH |
| 3/24 | " |
| 3/31 | " |
| 4/7 | " |
| 4/14 | " |
| 4/21 | " |
| 4/28 | " |
| 5/5 | " |
| 5/12 | " |
| 5/19 | " |

OVER

1948

6/1 Lans. ~~3959+~~ ? 2959 ?
5" @ 3035'
Acid 4,500
Pump 100 oil Pot.
Gr. 40.9°
TD 3074'
COMPLETED

Form 26 200 Bks. 10-46 Petrol

Hall-Gurney

Kansas

Map No. ____ Sec. 23 Twp. 14 R. 14W

Well No. 1 Gurney

Musgrove etal. Company

FIRST REPORT Contractor

C E L SW


1320 Ft. from N. Line

____ Ft. from S. Line

330 Ft. from E. Line

____ Ft. from W. Line

SECTION PLAT

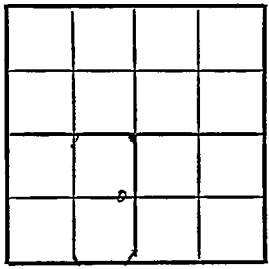

Russell County

Location ____

Rig up ____

Drilling and Remarks:

surface hole

RECORD

Cased ____ in., ____ ft.

Sand ____

Gas ____

Oil ____

Total Depth ____

PRODUCTION

1st 24 hrs. Nat. ____

1st 24 hrs. after shot ____

Gas ____ Cu. Ft.


Dry Hole ____

Abandoned ____

Date

FEB 11 1948 19

S. J. LEWIS Scout

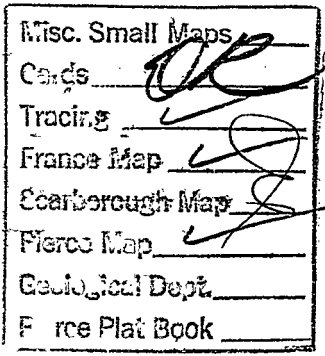
Misc. Small Maps
Cards
Tracing
France Map
Scarborough Map
Pierce Map
Geological Dept.
Pierce Plat Book

Hall-Gurney Pool

Form 26—200 Bks.—1-48—Palace

Kansas

Map No. 72 Sec. 23 Twp. 14 R. 14W

Well No. 1 Gurney


Musgrove Etal. Company

COMPLETE Contractor

C E L SW

El. 1822

SECTION PLAT

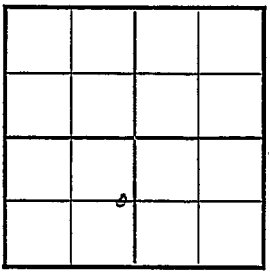

1320 Ft. from N. Line

Ft. from S. Line

330 Ft. from E. Line

Ft. from W. Line

Russell County

Location

Rig up

Drilling and Remarks:

Lans 2909

5" C 3085

405 Gas C

Pump 100 bbl Oil

40 Gas

RECORD

Cased in., ft.

Sand

Gas

Oil ✓

Total Depth 3074

PRODUCTION

1st 24 hrs. Nat.

1st 24 hrs. after shot


Gas Cu. Ft.

Dry Hole

Abandoned

Date

JUN 1 1948 19 S. J. LEWIS Scout

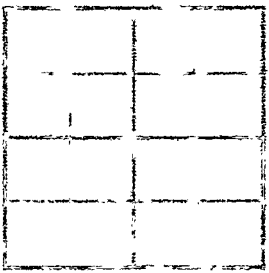

Misc. Small Maps
Cards
Tracing
France Map
Scarborough Map
Pierce Map
Geological Dept.
Plat Book