

Russell


Form 51-5M-5-34-Palace

Map No. _____ Sec. 24 Twp. 14 R. 15W

Well No. #2 Boyburger Farm _____

Lario & Tyle Company _____

NORTH

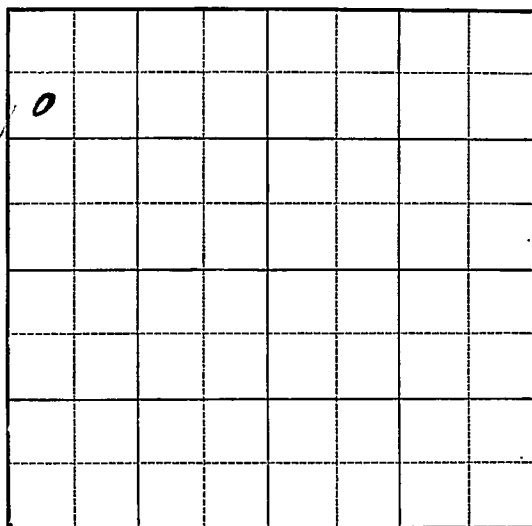

SOUTH

Location _____

Drilling Remarks _____

Rig Up _____

Drilling Remarks _____

RECORD

Cased _____ in. _____ ft.

Sand _____

Gas _____

Oil _____

Total Depth _____

PRODUCTION

1st 24 hrs. Nat. _____

1st 24 hrs. after shot _____

Gas _____ cu. ft.

Dry Hole _____

Abandoned _____

Russell


Map No. KANSAS Sec. 24 Twp. 14 R. 15^W
Well No. 2 Boyberger Farm
Lario & Tyke Company

990 Ft. from N. Line

_____ Ft. from S. Line

_____ Ft. from E. Line

330 Ft. from W. Line

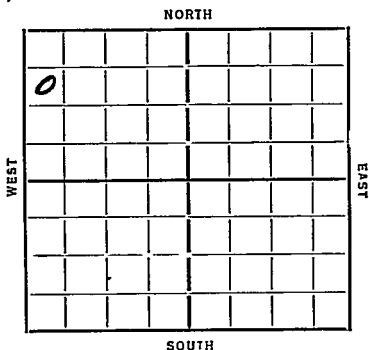

Date

REPORT

1/25
1/28 Cellar
1/31 Moving in
2/7 — 2/14 —
2/21 Ray
2/28 — 3/7 — 3/14 — 3/21 —
3/28 Rgn
4/4 — 4/11 — 4/18 — 4/26 —
5/2 345 run 15"
5/9 15" 387 867
5/16 12" 761 517 1315
5/23 Aly 1900
5/29 " 2470
6/6 Aly 2875 10" 2048
8" 2475 6" 2822
6/13 6" 2889 2990 4 R 6"
6/20 6" 3097 4009 3142-50
Aly 3160
6/28 Aly 3259 5" 3262
3200' Oil

OVER

7/2 Sil 3259
TJ 3262
1000 acid
1024 Sil 22 1/2 hrs
8% water

COMPLETED

Map No. 77 Sec. 24 Twp. 14 R. 15WWell No. 2-BohlerLario & Texas Company

Contractor

FIRST REPORTS

SECTION PLAT

990 Ft. from N. Line

0			

.....Ft. from S. Line

.....Ft. from E. Line

330 Ft. from W. LineLocation ✓

Rig up.....

Drilling and Remarks:

cellar

RECORD

Cased.....in.,ft.

Sand.....

Gas.....

Oil.....

Total Depth.....

PRODUCTION

1st 24 hrs. Nat.....

1st 24 hrs. after shot.....

Gas.....Cu. Ft.

Dry Hole.....

Abandoned.....

Date

ORVAL MANNSCHRECK

1-23-35 192.....Scout

Russell
 Map No. 72 Sec. 24 Twp. 14 R. 15W

Well No. 2-Boyerger

Lario & Texas Company

Contractor

COMPLETED

SECTION PLAT

990 Ft. from N. Line

_____ Ft. from S. Line

_____ Ft. from E. Line

330 Ft. from W. Line

0			
	1		

Location _____

Rig up _____

Drilling and Remarks:

1000 acid

1024 hpb

22 1/2 hrs

80% water

RECORD

Cased _____ in., _____ ft.

Sand *sl* 3259

Gas _____

Oil _____

Total Depth 3262

PRODUCTION

1st 24 hrs. Nat. _____

1st 24 hrs. after shot _____

Gas _____ Cu. Ft.

Dry Hole _____

Abandoned _____

Date

7-2-35 192

ORVAL MANNSCHRECK

Scout