

KANSAS


FORM 51 5M 10-41 PETROL

Russell

Section 24 Township 14 Range 15-W

Well No. #4 Boxberger

Company Lario Oil & Gas

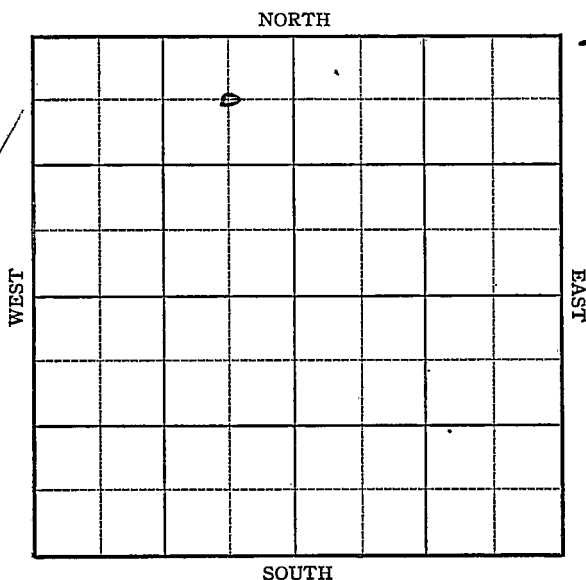

KANSAS

Russell

Sec. 24 Twp. 14 R. 15-W  
Well No. #4 Box Berger Farm  
Lario Oil & Gas Company


Gorham Pool

660 Ft. from N. Line

         Ft. from S. Line

660 Ft. from E. Line

         Ft. from W. Line

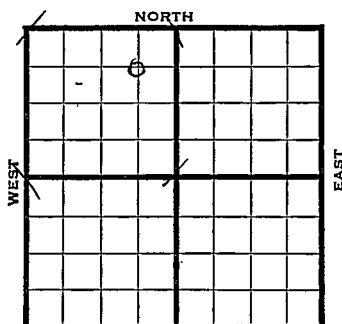

C NE NW

Elev. 1791

REPORT

| 1942  |                                                         |
|-------|---------------------------------------------------------|
| 12/22 | Loc.                                                    |
| 12/29 | "                                                       |
| 1943  | "                                                       |
| 1/6   | "                                                       |
| 1/13  | "                                                       |
| 1/20  | Rotary.                                                 |
| 1/27  | 8" Casing set 846'<br>Anhy 821 WOC.                     |
| 2/3   | Drlg. 2645'                                             |
| 2/10  | Topeka 2652<br>Lans 2955<br>Arb. 3221<br>T.D. 3226' SSO |
| 2/17  | Arb. 3221<br>T.D. 3231'<br>Water                        |

**ABANDONED**

KANSAS

Russell

Map No. 72 Sec. 24 Twp. 14 R. 15WWell No. 4 BoxbergerLario Oil & Gas Company

## FIRST REPORT

Contractor

C NE NW

## SECTION PLAT

660


Ft. from N. Line

Ft. from S. Line

660

Ft. from E. Line

Ft. from W. Line

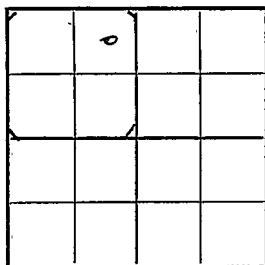

GORHAM POOL

Location XXX

Rig up

Drilling and Remarks:

## RECORD

Cased \_\_\_\_\_ in., \_\_\_\_\_ ft.

Sand \_\_\_\_\_

Gas \_\_\_\_\_

Oil \_\_\_\_\_

Total Depth \_\_\_\_\_

## PRODUCTION

1st 24 hrs. Nat. \_\_\_\_\_

1st 24 hrs. after shot \_\_\_\_\_

Gas \_\_\_\_\_ Cu. Ft.

Dry Hole \_\_\_\_\_

Abandoned \_\_\_\_\_

Date

DEC 22 1942 19

S. J. LEWIS Scout

KANSAS Russell

Map No. 72 Sec. 24 Twp. 14 R. 15WWell No. 4 BoxbergerLario Oil & Gas CompanyABANDONED Contractor

C NE NW

660 Ft. from N. Line         Ft. from S. Line660 Ft. from E. Line         Ft. from W. Line

## SECTION PLAT

|  |   |  |  |
|--|---|--|--|
|  | o |  |  |
|  |   |  |  |
|  |   |  |  |
|  |   |  |  |
|  |   |  |  |

GORHAM POOL

Location                     Rig up                     

Drilling and Remarks:

*Ar 83221**Water.*

## RECORD

Cased            in.,            ft.Sand                     Gas                     Oil                     Total Depth 3231

## PRODUCTION

1st 24 hrs. Nat.                     1st 24 hrs. after shot                     Gas                      Cu. Ft.Dry Hole                     Abandoned                     

Date

FEB 17 1943

19

S. J. LEWIS Scout