


Section 24 Township 14 Range 15W

Well No. 1 Mai

Company B & R Drig.

Hall-Gurney pool
NORTH

9

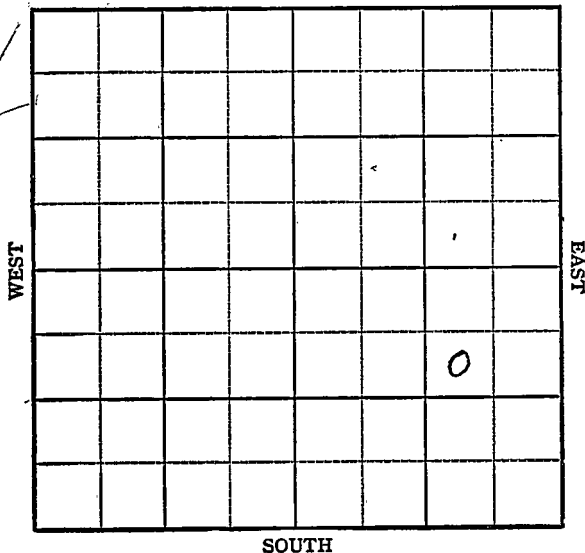

Sec. 24 Twp. 14 R. 15W

Well No. 1 Mai Farm


B & R Drlg. Company

Hall-Gurney Pool
990 Ft. from N. Line

Ft. from S. Line

990 Ft. from E. Line

Ft. from W. Line

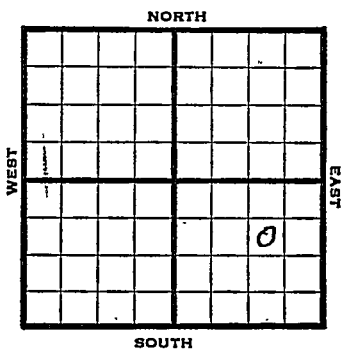

SW NE SE

1948 Eli 1804' REPORT

- 9/22 Location
- 9/29 "
- 10/6 8"@ 538'
- 10/13 Drlg 2805'
- 10/19 Lansing 2966'
Gorham 3208-11
TD3211
- 10/26 5"@ 3209
"
- 11/3 TD 3319'
Swb 3 bbls oil PH 8 hrs.
- 11/10 "
- 11/16 "
- 11/23 "
- 11/30 "
- 12/8 TD 3319'
Gorham 3208'
5"@ 3209'
Pump 50 Oil Pot
40⁹ Grl
Comp
COMPLETED

Map No. 72 Sec. 24 Twp. 14 R. 15W

Well No. 1 Mai

B & R Drlg. Company

COMPLETE Contractor

SW NE SE

E11804
SECTION PLAT

990 Ft. from N. Line

 Ft. from S. Line

990 Ft. from E. Line

 Ft. from W. Line

			o

Russell County

RECORD

Location _____

Rig up _____

Drilling and Remarks:

Drillham 3208

5" @ 3209

Prod 50 oil Prod

40 E.H.

Cased _____ in., _____ ft.

Sand _____

Gas _____

Oil

Total Depth *3219*

PRODUCTION

1st 24 hrs. Nat. _____

1st 24 hrs. after shot _____

Gas _____ Cu. Ft.

Dry Hole _____

Abandoned _____

Date

DEC 8 1948

19

S. I. LEWIS

Scout