
Russell

FORM 51 10M 12-46 PRINTED IN KANSAS

Section 24 Township 14 Range 15W

Well No. 3 Mai

Company Fred Haynes

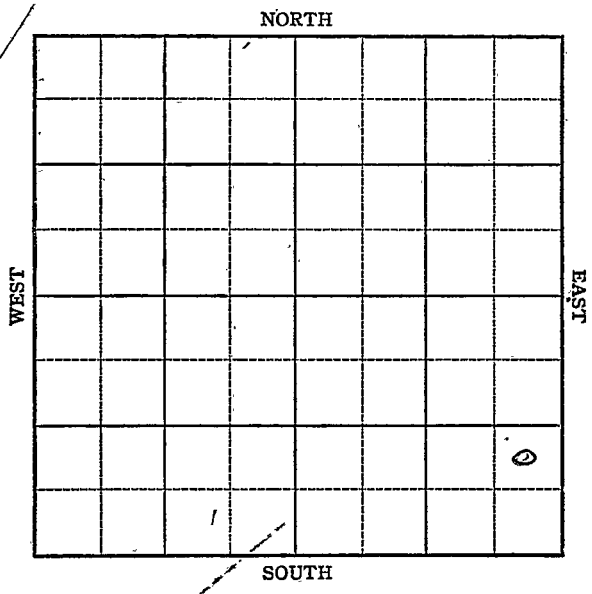

FORM 252-A
5M 12-46 PETROL

KANSAS Russell

Sec. 24 Twp. 14 R. 15-W

Well No. 3 Mai Farm


Fred Haynes Company

____ Ft. from N. Line

990 Ft. from S. Line

330 Ft. from E. Line

____ Ft. from W. Line

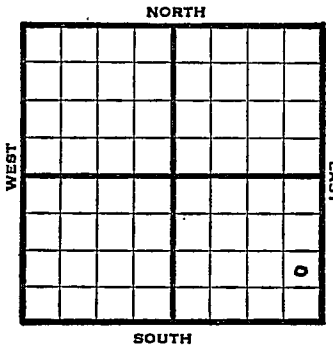

NE SE SE

1947	Elev. 1833' REPORT
6/4	12" @ 475' Drlg. 750'
6/10	10" @ 842' Drlg. 1700'
6/17	8" @ 2315' Drlg 2320'
6/24	Topeka 2705' - 2725' Run 7"
7/1	Lansing 2985' TD 2990' Run 8"
7/8	7" @ 2985' TD 3029'
7/16	Lansing 2985' 7" @ 2985' 1000 Acid Pump 150 Pot Gr. 40 T.D. 3029' COMPLETED

Form 26 200 Bks. 10-46 Petrol

Kansas

Trapp Pool

Map No. _____ Sec. 24 Twp. 14 R. 15W


Well No. 3 Mai

Fred Haynes Company

FIRST REPORT Contractor

NE SE SE

SECTION PLAT

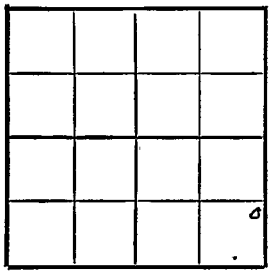

_____ Ft. from N. Line

990 Ft. from S. Line

330 Ft. from E. Line

_____ Ft. from W. Line

Russell County

Location

Rig up

Drilling and Remarks:

12" @ 475

drlg. 750

RECORD

Cased _____ in., _____ ft.

Sand

Gas

Oil

Total Depth

PRODUCTION

1st 24 hrs. Nat.

1st 24 hrs. after shot

Gas _____ Cu. Ft.

Dry Hole

Abandoned

Date

JUN 4 1947 19 S. J. LEWIS Scout

Form 26 200 Bks. 10-46 Petrol

Kansas

Trapp Pool

Map No. 72 Sec. 24 Twp. 14 R. 15W

Well No. 3 Mai


Fred Haynes Company

COMPLETE Contractor

NE SE SE

Elev. 1833

SECTION PLAT

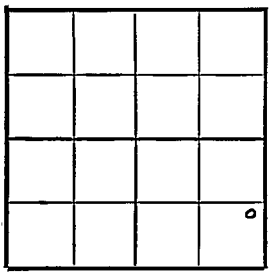

____ Ft. from N. Line

990 Ft. from S. Line

330 Ft. from E. Line

____ Ft. from W. Line

Russell County

Location

Rig up

Drilling and Remarks:

Lans 2985

7" @ 2985

1000 Gal Acid

Pump 150 BW

40° Gr

RECORD

Cased ____ in., ____ ft.

Sand

Gas

Oil

Total Depth 3029

PRODUCTION

1st 24 hrs. Nat.

1st 24 hrs. after shot

Gas ____ Cu. Ft.

Dry Hole

Abandoned

Date

JUL 16 1947 19

S. J. LEWIS Scout