

KANSAS

Russell

FORM 51 5M PETROL

Section ~~34~~ 24 Township 14 Range 15WWell No. #3 Mai "C"Company Citiés Service Oil


Trapp pool

NORTH

WEST

EAST

SOUTH

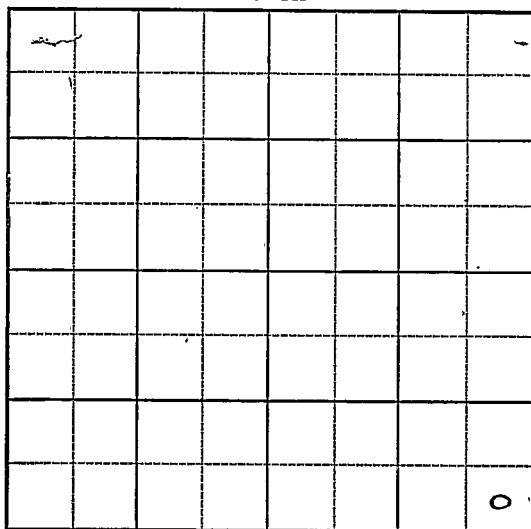

KANSAS

Russell

Sec. 24 ~~34~~ Twp. 14 R. 15 ~~W~~Well No. #3, Mai "C" FarmCities Service Oil Company

Ft. from N. Line

330


Ft. from S. Line

330

Ft. from E. Line

Ft. from W. Line

Elev. 1832

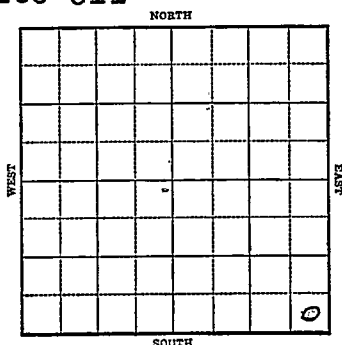

R E P O R T

1943	
12/15	Rotary
12/22	8" @ 345 WOC.
12/29	1590 SD
1944	
1-5	Drlg 2945'
1-12	Lans 2999 Gorham 3240 TD 4" @ 3240 RUST
1/19	" "
1/26	" "
2/2	Gorham 3237 Corrected 4" @ 3237 TD 3247-1500' oil in 58 hrs.
2/8	47 shots 3237-43 CO
2/15	Pump 18 oil in 8 hrs 5 qts 3240-44 fsg. tools.
2/23	" " " "
3/1	" " " "
3/8	" " " "
3/16	" " " "

OVER

1944
3/22 Pump 18 oil in 8 hrs. 6 qts
3240-44 fsg. tools.

3/29 4" @ 3237
Gorhan 3237
TD 3247
Water.

ABANDONED

Map No. KANSAS 72 Sec. 34 Twp. 14 R. 15W

Well No. 3 Mai "C"

Cities Service Oil Company

FIRST REPORT Contractor

SE/C


SECTION PLAT

 Ft. from N. Line

330 Ft. from S. Line

330 Ft. from E. Line

 Ft. from W. Line

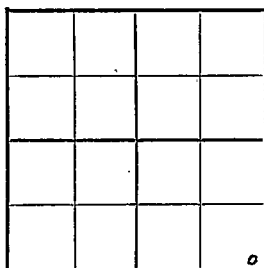

Trapp Pool

Location

Rig up

Drilling and Remarks:

Rotary

RECORD

Cased in., ft.

Sand

Gas

Oil

Total Depth

PRODUCTION

1st 24 hrs. Nat.

1st 24 hrs. after shot

Gas Cu. Ft.

Dry Hole

Abandoned


Date

DEC 15 1943 19 S. J. LEWIS Scout

Map No. 72 Sec. 24 Twp. 14 14 15WWell No. 3 Mai "C"Cities Service Oil CompanyCORRECTION Contractor

SE/C

SECTION PLAT

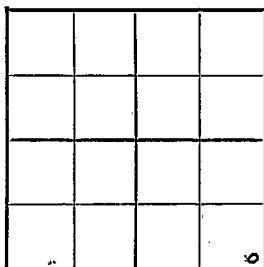 Ft. from N. Line330 Ft. from S. Line330 Ft. from E. Line Ft. from W. Line

Trapp Pool

Location Rig up

Drilling and Remarks:

Reported

34-14-15W

RECORD

Cased in., ft.Sand Gas Oil Total Depth

PRODUCTION

1st 24 hrs. Nat. 1st 24 hrs. after shot Gas Cu. Ft.Dry Hole Abandoned

Date

DEC 15, 1943

19


S. J. LEWIS Scout

KANSAS

Map No. 72 Sec. 24 Twp. 14 R. 15^WWell No. 3 Mai "C"Cities Service Oil CompanyABANDONED Contractor

SE/C

SECTION PLAT

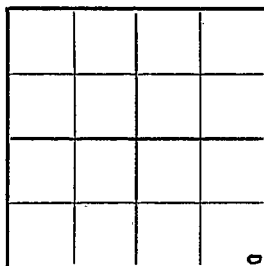 Ft. from N. Line330 Ft. from S. Line330 Ft. from E. Line Ft. from W. Line

Trapp Pool

Location Rig up

Drilling and Remarks:

*Gas came 3237**4 "C 3237**Water*

RECORD

Cased in., ft.Sand Gas Oil Total Depth 3247

PRODUCTION

1st 24 hrs. Nat. 1st 24 hrs. after shot Gas 56.41 Cu. Ft.Dry Hole Abandoned

Date

MAR 29 1944 19

S. J. LEWIS Scout