
KANSAS
FORM 51 5M PETROL

Russell

Section 24 Township 14 Range 15W

Well No. #4 Mai "C"

Company Cities Service Oil

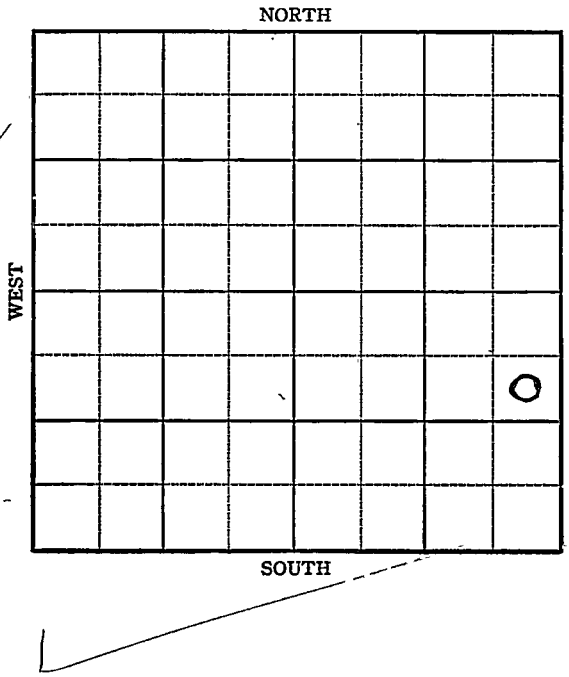

9

FORM C-524
5M-6-44 PETROL

Russell

Sec. 24 Twp. 14 R. 15W

Well No. #4 Mai "C" Farm

Cities Service Oil Company


Big Creek

990 Ft. from N. Line

_____ Ft. from S. Line

330 Ft. from E. Line

_____ Ft. from W. Line

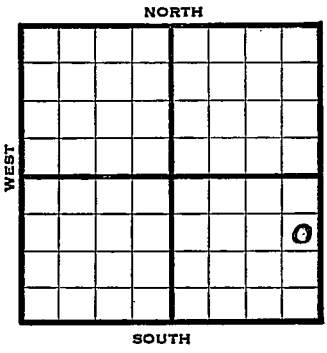

Elev. 1827

1944	REPORT
4/12	Location
4/19	"
4/26	"
5/3	"
5/10	8" @ 303 WOC
5/17	Drlg. 2848
5/24	Lans 2995 SO 3001-03 3019-22 Gorham 3238 TD 3241 5" @ 3239 RUST
5/31	SLM 3241-32 Gorham 3229- 5" @ 3230 TD 3241-swb 45 oil in 13 hrs.
6/7	Pump 13 oil in 15 hrs.
6/15	" " " " " "
6/21	" " " "
6/28	" " " " "

OVER

1944

7/12 Pump 13" oil in 15 hours
7/19 " " " " " "

7/26 Goeham 3229
5" @ 3230
Pump 23 Pot.
Grav. 33.
TD 3241

COMPLETED

Form 26 200 Bks 5-42 Petrol Russell

KANSAS

Map No. 72 Sec. 24 Twp. 14 R. 15W

Well No. 4 Mai "C"

Cities Service Oil Company

FIRST REPORT Contractor

SE NE SE


990 Ft. from N. Line

_____ Ft. from S. Line

330 Ft. from E. Line

_____ Ft. from W. Line

SECTION PLAT

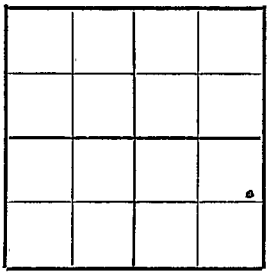

Big Creek Pool

Location X

Rig up

Drilling and Remarks:

RECORD

Cased _____ in., _____ ft.

Sand

Gas

Oil

Total Depth

PRODUCTION

1st 24 hrs. Nat.

1st 24 hrs. after shot

Gas _____ Cu. Ft.

Dry Hole

Abandoned

Date

APR 12 1944 19 S. I. LEWIS Scout

FORM 26 200 BKS 2-44 PETROL

KANSAS

Pool Name Big Creek

Map No. 72 Sec. 24 Twp. 14 R. 15W

Well No. 4 Mai "C"

Cities Service Oil Company

COMPLETED Contractor

SE NE SE

990 Ft. from N. Line


Ft. from S. Line

330 Ft. from E. Line

Ft. from W. Line

Russell County

SECTION PLAT

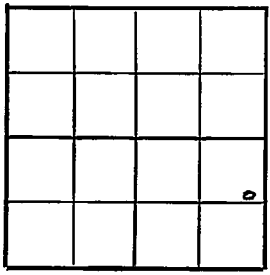

Location

Rig up

Drilling and Remarks:

Got sam 3229

5" @ 3230

Pump 20 BF

83 BO

RECORD

Cased in., ft.

Sand

Gas

Oil

Total Depth 3244

PRODUCTION

1st 24 hrs. Nat.

1st 24 hrs. after shot

Gas Cu. Ft.

Dry Hole

Abandoned

Date

JUL 2 6 1944 19

S. J. LEWIS Scout