


Section 24 Township 14 Range 15WWell No. #1 MilbergerCompany Keystone Petroleum et al

NORTH

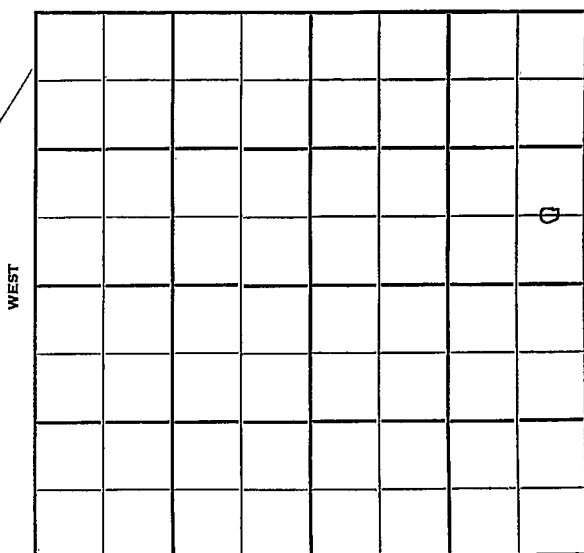

SOUTH

Russell KANSAS

Sec. 24 Twp. 14 R. 15 W

Well No. # 1 Milberger Farm

Keystone Petroleum et al Company

Murfin Drlg. Contractor


Ft. from N. Line

660 Ft. from S. Line

330 Ft. from E. Line

Ft. from W. Line

C E L S E N E

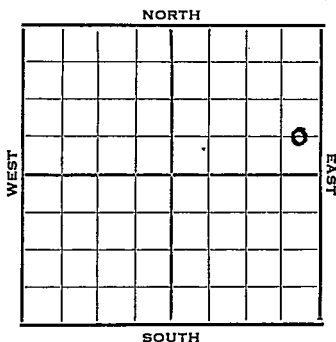

1952

Elev. 1819'

REPORT

4/23 Cellar & Pits
4/30 "
5/7 "
5/14 "
5/21 "
5/28 "
6/11 Abd. Location

ABANDONED

County Russell State Kansas
 Sec. 24 (Blk.) 14 (Sur.) 15W Map No. _____
 Operator Keystone Petroleum etal.
 Well No. 1 Farm Milberger
 Elev. _____ Location C E L SE NE


FIRST REPORT 0

660 Ft. From S Line NE
330 Ft. From E Line Quarter
 1st. Report APR 23 1952
 Completion _____
 Remarks _____
Murfin Drlg. - Contr.
 Spudding Date _____

Drlg. Data

Cellar & pits

J. G. McGEHEE

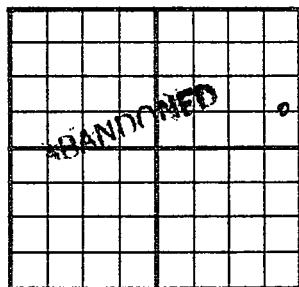County Russell State KansasSec. 24 (Blk.
Twp.) 14 (Sur.
Rge.) 15W Map No.Operator Keystone Petroleum etal.Well No. 1 Farm MilbergerElev. 1819 Location C E L S E N E660 Ft. From S Line NE330 Ft. From E Line Quarter1st. ReportCompletion JUN 11 1952RemarksMurfin Drlg. - Contr.Spudding DateDrlg. DataAbd. location

J. G. McGEHEE