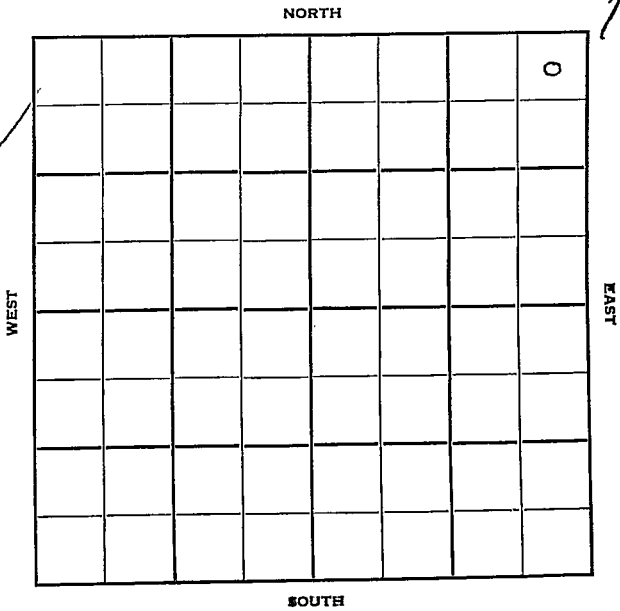


Section 24 Township 14 Range 15-WWell No. #2 ReinhardtCompany Braden Oil

KANSAS

Russell

Sec. 24 Twp. 14 R. 15-W

Well No. #2 Reinhardt Farm

Braden Oil Company

Contractor


330 Ft. from N. Line

Ft. from S. Line

330 Ft. from E. Line

Ft. from W. Line

NE NE NE

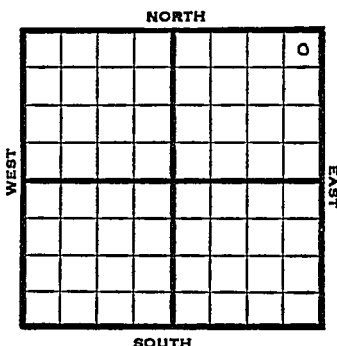

1950 Elev 1817 REPORT

5/24 Location

8/23 TD 3232
8 5/8" @ 528
Anhy 847 Arb 3229-3232
FU 800' oil 12 hr SP 3210
24/3169-73 500 A S/1/3 boph 4000 A
S/4 bw 1/2 boph Sq off
DD 3232
Comp 65 bopd
Completed

COMPLETED

Map No. _____ Sec. 24 Twp. 14 R. 15WWell No. 2 Reinhardt Reinhardt

Braden Oil _____ Company

Contractor _____

~~NE~~ NE NE
~~NE~~

SECTION PLAT

			φ 0

330 Ft. from N. Line

Ft. from S. Line

330~~330~~ Ft. from E. Line

Ft. from W. Line

Russell

Location Y

Rig up _____

Drilling and Remarks:

RECORD

Cased _____ in., _____ ft.

Sand _____

Gas _____

Oil _____

Total Depth _____

PRODUCTION

1st 24 hrs. Nat. _____

1st 24 hrs. after shot _____

Gas _____ Cu. Ft.

Dry Hole _____

Abandoned _____

Date

MAY 24 1950

19

J. E. TYRA

Scout

Kansas

Map No. _____ Sec. 24 Twp. 14 R. 15WWell No. 2 Reinhardt

Braden Drlg. _____ Company _____

CORRECTION

Contractor _____

NE NE NE

E. 1817

SECTION PLAT

330 _____ Ft. from N. Line

_____ Ft. from S. Line

330 _____ Ft. from E. Line

_____ Ft. from W. Line

			0

Russell County

Location _____

Rig up _____

Drilling and Remarks:

Reported _____

NW NE NE

RECORD

Cased _____ in., _____ ft.

Sand _____

Gas _____

Oil _____

Total Depth _____

PRODUCTION

1st 24 hrs. Nat. _____

1st 24 hrs. after shot _____

Gas _____ Cu. Ft.

Dry Hole _____

Abandoned _____

Date

JUN 7 1950 19J. E. TYRA Scout

County Russell State KansasSec. 24 (Bk.
Twp.) 14 (Sur.
Rge.) 15W Map No.Operator Braden OilWell No. 2 Farm ReinhardtElev. 1817 Location NE NE NE

							0

330 Ft. From N Line NE

330 Ft. From E Line Quarter

1st. Report

Completion AUG 23 1950

Remarks

Spudding Date

Drlg. Data Oil well TD 32328 5/8" @ 528 Anhy 847 Arb. 3229-3232FU 800' oil 12 hr. SP 3210 24/ 3169-73500 A S/ 1/3 boph 4000 A S/ 4 bw 1/2 bophSq. off DD 3232 Comp. 65 bopd

J. E. TYRA