

KANSAS

Russell

Section 24 Township 14 Range 15W

Well No. 1 Boxberger

Company Collinson

Big Creek Pool

NORTH

5

| | | | | | | | |
|--|---|--|--|--|--|--|--|
| | | | | | | | |
| | | | | | | | |
| | | | | | | | |
| | 0 | | | | | | |
| | | | | | | | |
| | | | | | | | |
| | | | | | | | |
| | | | | | | | |

WEST

EAST

SOUTH



KANSAS

Sec. 24 Twp. 14 R. 15W ✓

Well No. #1 Boxberger Farm

Collinson

Company


Big Creek Pool

_____ Ft. from N. Line

330' Ft. from S. Line

_____ Ft. from E. Line

330' Ft. from W. Line

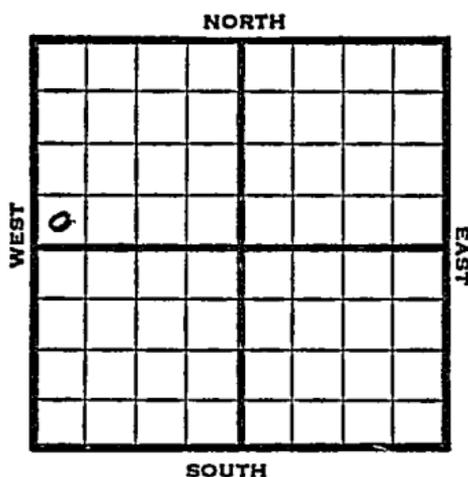

SW NW

1949 Elev 1798' REPORT

4/13 8" @ 309'
Anhy 838'
Drlg. 1315'

4/20 Lansing 2971'
Drlg 3157'

4/27 "

5/4 Arb. 3210
5" @ 3210
TD 3214'
1400' oil

5/10 "

5/18 Pump 60 bbls oil 21 hrs.

5/25 TD 3214'
Arb. 3210'
5" @ 3210'
300 acid
Pump 105 Oil Pot
36° Gr.
Comp

COMPLETED

Map No. _____ Sec. 24 Twp. 14 R. 15^W

Well No. 1 Boxberger

Collinson Company

FIRST REPORT

Contractor

SW NW

SECTION PLAT

_____ Ft. from N. Line

330 Ft. from S. Line

_____ Ft. from E. Line

330 Ft. from W. Line

| | | | |
|--|--|--|--|
| | | | |
| | | | |
| | | | |
| | | | |

Russell County

Location _____

Rig up _____

Drilling and Remarks:

8" @ 309

anhy 838

drlg. 1315

RECORD

Cased _____ in., _____ ft.

Sand _____

Gas _____

Oil _____

Total Depth _____

PRODUCTION

1st 24 hrs. Nat. _____

1st 24 hrs. after shot _____

Gas _____ Cu. Ft.

Dry Hole _____

Abandoned _____

Date

APR 13 1949

S. J. LEWIS

Scout

Map No. K72 Sec. 24 Twp. 14 R. 15W

Well No. 1 Boxberger

Collinson

Company

COMPLETE

Contractor

SW NW

E 41798

SECTION PLAT

| | | | |
|--|--|--|--|
| | | | |
| | | | |
| | | | |
| | | | |

_____ Ft. from N. Line

330 Ft. from S. Line

_____ Ft. from E. Line

330 Ft. from W. Line

Russell County

Location _____

Rig up _____

Drilling and Remarks:

Case 3210

5' case 3210

300 feet

Run 105 oil test

96 - 1/2

RECORD

Cased _____ in., _____ ft.

Sand _____

Gas _____

Oil _____

Total Depth 9214

PRODUCTION

1st 24 hrs. Nat. _____

1st 24 hrs. after shot _____

Gas _____ Cu. Ft.

Dry Hole _____

Abandoned _____

Date

MAY 25 1949 19

S. J. LEWIS Scout