

Russell

KANSAS

FORM 51 25M 3-49 PETROL

Section 24 Township 14 Range 15W

Well No. #1 Boxberger


Company #1 Capitan

NORTH

WEST

EAST

SOUTH

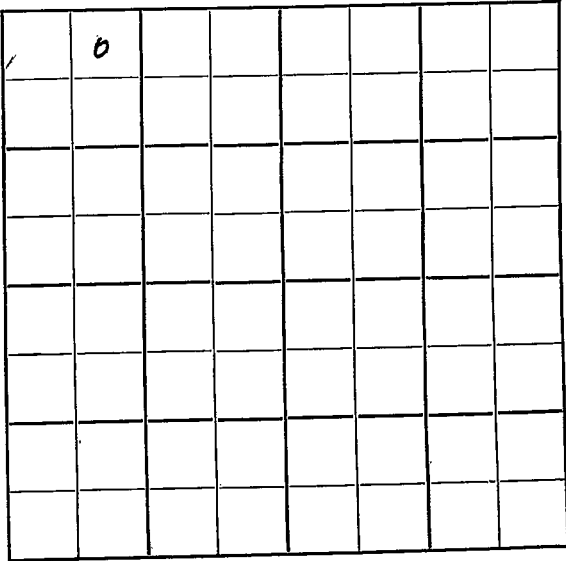

	0						



KANSAS

Russell

Sec. 24 Twp. 14 R. 15-W

Well No. #1 Boxberger Farm

El Capitan Company
Big Creek


330 Ft. from N. Line

_____ Ft. from S. Line

_____ Ft. from E. Line

990 Ft. from W. Line

NE NW NW Oil Well

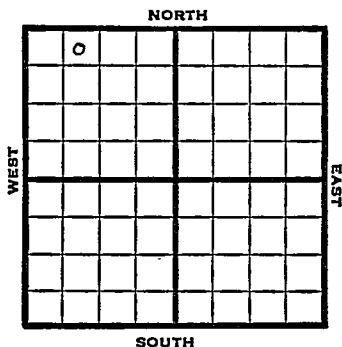

1950 Elev 1800 R E P O R T

7/26 Location

9/13 Spud 7-26-50

Anhy 835

8" @ 845

Arb 3214-16

5" @ 3215

Comp. 25 bopd

50% water

TD 3216

Completed

COMPLETED

Kansas

Map No. _____ Sec. 24 Twp. 14 R. 15WWell No. 1 BoxbergerEl Capitan

Company

Contractor

NE NW NW

330

Ft. from N. Line

Ft. from S. Line

Ft. from E. Line

990

Ft. from W. Line

SECTION PLAT

Russell CountyLocation X

Rig up

Drilling and Remarks:

RECORD

Cased _____ in., _____ ft.

Sand _____

Gas _____

Oil _____

Total Depth _____

PRODUCTION

1st 24 hrs. Nat. _____

1st 24 hrs. after shot _____

Gas _____ Cu. Ft.

Dry Hole _____

Abandoned _____


Date

JUL 26 1950

19

J. E. TYRA

Scout

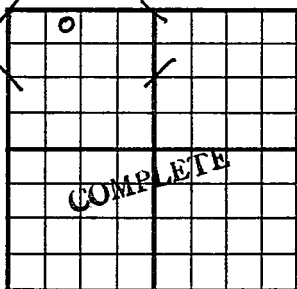County Russell State KansasSec. 24 (Blk.
Twp.) 14 (Sur.
Rge.) 15W Map No.Operator El CapitanWell No. 1 Farm Boxberger "B"Elev. 1800 Location NE NW NW330 Ft. From N Line NW990 Ft. From W Line Quarter

1st. Report

Completion SFP 1.3 1950

Remarks

Big Creek PoolSpudding Date 7-26-50Drilg. Data Oil well TD 3216Anhy 835 8" @ 845 Arb. 3214-165" @ 3215 Comp. 25 bopd 50% water

J. E. TYRA