

KANSAS Russell

FORM 51 5M 4-41 PETROL

Section 24 Township 14 Range 15-W

Well No. #2 Boxberger

Company John Lindas et al


Big Creek Pool


NORTH

WEST

EAST

SOUTH

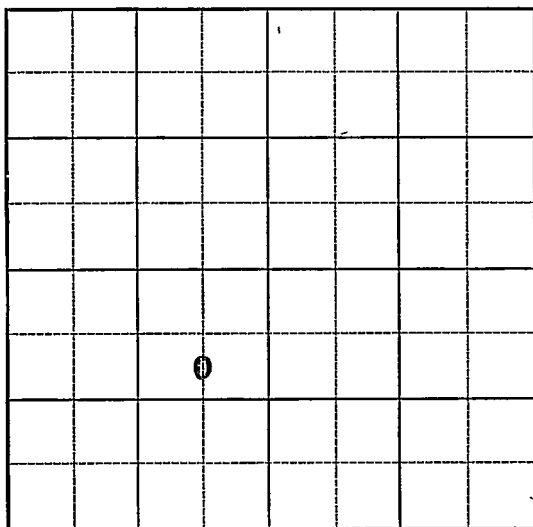

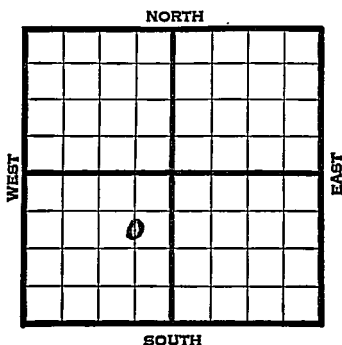[illegible]

Map No. 72 Sec. 24 Twp. 14 R. 15WWell No. 2 Boxberger

John Lindas etal

Company

Contractor

FIRST REPORT

C S L NE SW

990 Ft. from N. Line Ft. from S. Line660 Ft. from E. Line Ft. from W. Line

BIG CREEK POOL

SECTION PLAT

Location Rig up

Drilling and Remarks:

Drilling 300

Rotary

RECORD

Cased in., ft.Sand Gas Oil Total Depth

PRODUCTION

1st 24 hrs. Nat. 1st 24 hrs. after shot Gas Cu. Ft.Dry Hole Abandoned

Date

APR 16 1941 19 S. J. LEWIS Scout

Map No. 72 Sec. 24 Twp. 14 R. 15WWell No. 2 BoxbergerJohn Lindas et al CompanyCOMPLETED Contractor

C S L N E SW

990 Ft. from N. Line Ft. from S. Line660 Ft. from E. Line Ft. from W. Line

BIG CREEK POOL

SECTION PLAT

Location Rig up

Drilling and Remarks:

*Cu Y 8206**5" C 8206**1000 Acro'l**Dry Hole Y 723**320 GN*

RECORD

Cased in., ft.Sand Gas Oil Total Depth 3212

PRODUCTION

1st 24 hrs. Nat. 1st 24 hrs. after shot Gas Cu. Ft.Dry Hole Abandoned

Date

MAY 27 1941 19 S. J. LEWIS Scout